


U.S. PUBLIC LAND SURVEY MONUMENT RECORD

Note: This form is intended and designed to fulfill all requirements of Wisconsin Administrative Code, Chapter A-E 7.08 U.S. Public Land Survey Monument Record (3) (a) (b) (c) (d) (e) (f) (g) (h) (i). An additional sheet may be added if necessary to conform with said requirements.

(a) Corner location: Township 37 North
 Range 7 East/West
 Town/City/Village Cassian
 County Oneida

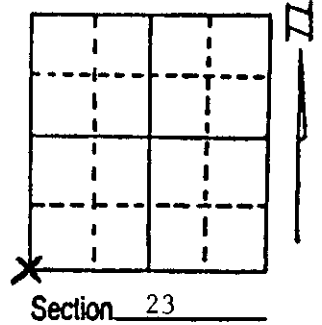

(b) (f) (g) (h) Description of monument found at this corner and if it was accepted, state all evidence (material, testimonial, occupational, plats, records, other monuments) used as a basis for accepting. If not accepted or if nothing was found, state evidence used as basis for establishing location. If reestablished through lost corner proportionate methods, indicate all monuments, distances and directions used to establish. Indicate type of monument found or set and sign post.

November 1862 - Joseph H. Jenkins established this corner and set a wood post at 80.00 chains:

- | | |
|-----------------------------|------------------------------|
| 9" Y. Pine, N58°E, 6 links | 12" W. Pine, S48°W, 14 links |
| 7" Y. Pine, S51°E, 24 links | 10" Y. Pine, N11°W, 19 links |

7/1/1936 - V. Maine restored corner from remains of original BTs - marks plain on 12" W. Pine, S48°W, 14 links - stumps of other BTs here but badly burnt; set a county B.C. with new BTs:

- 5" Black Oak, N80°E, 79 3/4 links (52.64')
- 8" W. Pine Stump, S80°W, 48 links (31.68')
- 5" Jack Pine, S54°E, 13 1/2 links (8.91')
- 12" Red Pine Stump, N43°W, 56 links (36.96')


2/14/89 - Milo E. Stefan found county corner by Maine in good condition. All Maine's BTs gone except the Jack Pine is a stump with scribing visible and Red Pine stump N43°E, 36.9'.

(c) (d) (e) Plan view of corner with ties to at least 4 witness monuments. If in disagreement with previously established corner, show the distances between the two corners and also indicate the ties to the disputed corner.

1. 2" x 60" iron pipe with brass cap.
2. 5" Red Oak, N33°E, 13.76'
3. 7" Red Oak, S34°E, 40.85'
4. 12" Jack Pine, S80°W, 24.61'
5. 8" Red Oak, N13°W, 51.30'
6. Plastic sign post, SE, 1.1'

Distances measured to nail in side of tree.

Trees scribed "BT" in stump blaze.

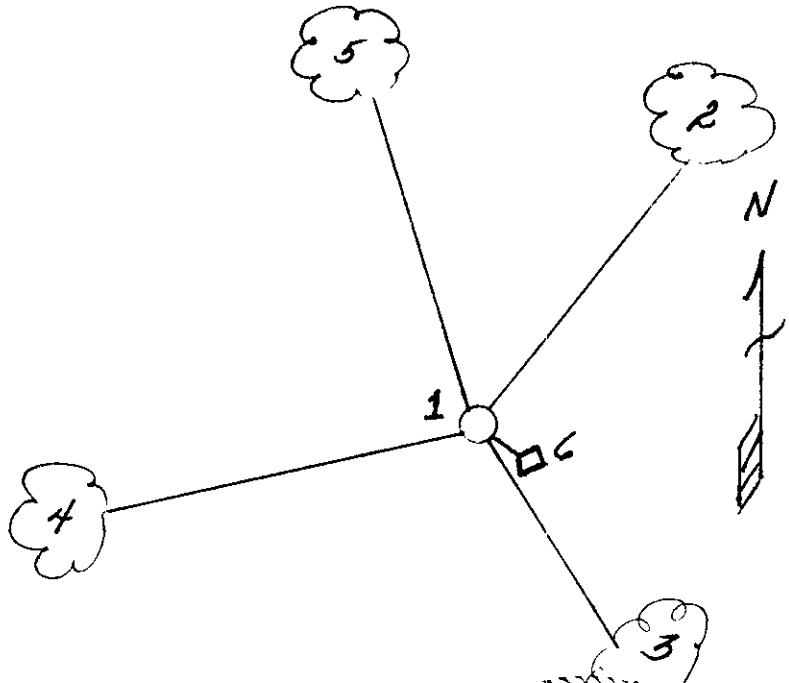

(i) I, Milo E. Stefan
 (type or print name) certify that the corner location on this record was determined by me or under my direction and control and that this U.S. Public Land Survey Monument Record is correct and complete to the best of my knowledge and belief.

Milo E. Stefan
 Signature

2/16/89
 Date



Index No. R-17

3707220000