

# U.S. PUBLIC LAND SURVEY MONUMENT RECORD


NOTE: This form is intended and designed to fulfill all requirements of Wisconsin Administrative Code, Chapter A-E 7.08 U.S. Public Land Survey Monument Record (3)(a)(b)(c)(d)(e)(f)(g)(h)(i). An additional sheet may be added if necessary to conform with said requirements.

(a) Corner location: Township 37 North

Range 7 East

Town of Cassian

Oneida County, Wisconsin

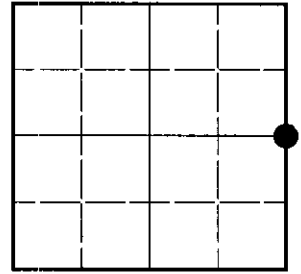

Section 22


(b)(f)(g)(h) Description of monument found at this corner and if it was accepted, state all evidence (material, testimonial, occupational, plats, records, other monuments) used as a basis for accepting. If not accepted or if nothing was found, state evidence used as basis for establishing location. If reestablished through lost corner proportionate methods, indicate all monuments, distances and directions used to establish. Indicate type of monument found or set and sign post.

November, 1862: Joseph Jenkins, U.S. Deputy Surveyor, set a wood post witnessed by a Y.Pine 12" S45°E, 30 lks. and a W.Pine 7" S40°W, 20 lks.

July, 1936: Vernon Maine, Oneida County Surveyor, set a brass capped iron pipe witnessed by a W.Pine 22" S87°E, 0.96 ch. and a Y.Pine 12" N70°W, 1.47 ch. It appears this corner was established based on single proportionate measure.

January 9, 1997: I found and accepted a 2-1/2" dia. iron pipe with a 2-1/2" dia. brass cap 32" above grade and marked as shown below. I established accessories as shown below and set a plastic sign post Southwest, 1 foot.

(c)(d)(e) Plan view of corner with ties to at least 4 witness monuments. If in disagreement with previously established corner, show the distances between the two corners and also indicate the ties to the disputed corner.

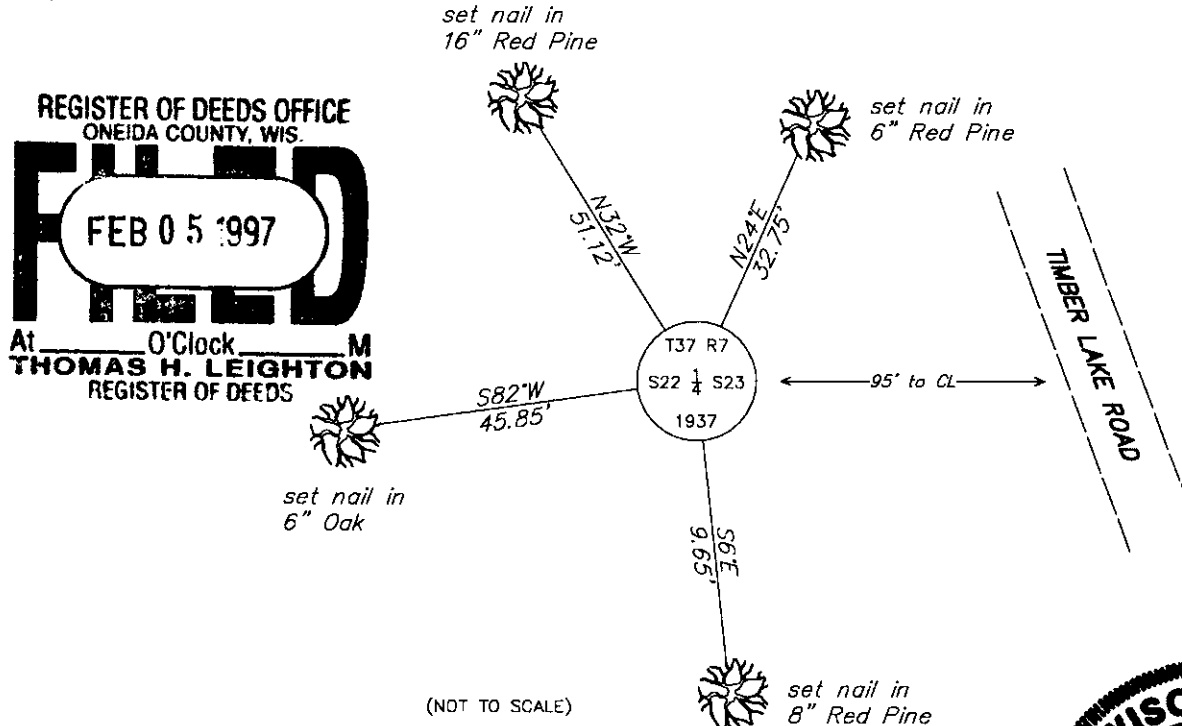

REGISTER OF DEEDS OFFICE  
ONEIDA COUNTY, WIS.  
**FILED**  
FEB 05 1997  
At O'Clock M  
THOMAS H. LEIGHTON  
REGISTER OF DEEDS

(NOT TO SCALE)

(i) I, Devon Vanden Heuvel, Registered Land Surveyor #S-1795, hereby certify that the corner location on this record was determined by me or under my direction and control and that this U.S. Public Land Survey Monument Record is correct and complete to the best of my knowledge and belief.



Index No. P-17

*Devon Vanden Heuvel*  
Signature

1-10-97  
Date

3707222000