



CERTIFIED LAND CORNER RESTORATION

State of Wisconsin }
County of Oneida } ss.

I William Immich, do hereby certify that on the 13th day of Dec., 1981, I found evidence of the North 1/4 corner of Section 25 Township 37 North, Range 7 East, Fourth Principal Meridian, as described hereon; and that from this evidence I established a new monument and accessories as described hereon to perpetuate the original location of this corner:

Description of original monument and accessories and subsequent restorations:

Jenkins
Joseph H. Jrukuis, Gov't Surveyor, 1862
East random between 24 & 25 var. 6 3/4
80.50 range line 7 south of post West corrected
40.25 set 1/4 post W. Pine 12 N 10 E 291k / Maple 7 S 61 E 221k
1920 D.H. Maine reset corner by proportionate measure (see book 8 P 164)
1960s Sy Poskie map (no date) shows corner in distance to 1/16 east 1325.5
also shows North South 1/4 line

Description of corner evidence found:


1968 Ivan Branham shows corner in by Maine (cannot find record of this being Maines corner) shows distance to 1/16th west 20.22 chains 1334.52'
1979 W. Immich found iron bar made bearing trees distance to 1/16 East 1324.48' fit Sy Poskie good
1981 W. Immich found iron bar distance to 1/16 West 1333.42' fit Branham distance good.

Description of monument and accessories I established to perpetuate the location of this corner:

found 1" iron bar in rock pile my old b.t.s in place
4" Norway Pine S 77 W 43.60'
6" W. Birch S 45 E 7.40'
14" Norway Pine N 76 E 57.81'
centerline dirt road South 30'
bearings mag. / distances to spike in side of tree



Corner data checked with record & accepted as correct
Robert H. Winkler, Oneida County Surveyor

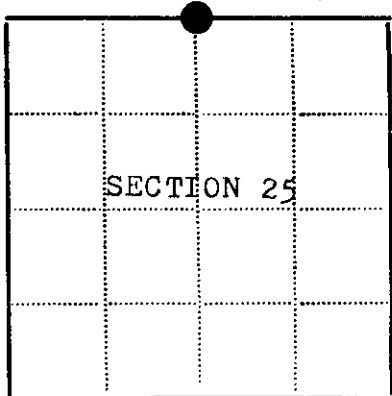

● - Corner monument restored
□ -

Resident witnesses.....

Dated at Rhinelander Wisconsin, this 13th day of Dec., 1981.

Signature *William Immich* Title R.L.S.
(County Surveyor, Registered Land Surveyor, or other duly authorized official)

Surveyors Registration No. 1383

Office of Registrar of Deeds County of Oneida

I hereby certify that the within instrument was filed in this office for record on the 25th day of August 1982 and was filed in Book No. Page No. of County Records.

Signature *Doris Verage Kuehn* Title Registrar of Deeds

Township, Range, Section, Index No., Page No.

3707240020

2-23


U.S. PUBLIC LAND SURVEY MONUMENT RECORD

Note: This form is intended and designed to fulfill all requirements of Wisconsin Administrative Code, Chapter A-E 5.02, U.S. Public Land Survey Monument Record (3) (a) (b) (c) (d) (e) (f) (g) (h) (i). An additional sheet may be added if necessary to conform with said requirements.

(a) Corner location: Township 37 North
Range 7 East/West

Town/City/Village Cassian

County Oneida

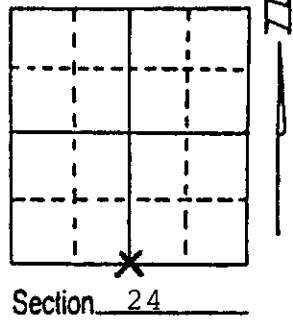

(b) (f) (g) (h) Description of monument found at this corner and if it was accepted, state all evidence (material, testimonial, occupational, plats, records, other monuments) used as a basis for accepting. If not accepted or if nothing was found, state evidence used as basis for establishing location. If reestablished through lost corner proportionate methods, indicate all monuments, distances and directions used to establish.

November, 1862, Joseph H. Jenkins, set post for 1/4 corner.

Original BTs = 12" White Pine, N10°E, 29 links (19.14').

= 7" Maple, S61°E, 22 links (13.86').

November 19, 1987, Milo E. Stefan, found:

1. 1" x 24" solid steel rod in mound of stone, with very old top of cedar post along side.
- *2. 20" Red Pine with BT face overgrown, N80°E, 57.79'.
- *3. 10" White Birch, with BT face open & scribing visible, S28°E, 7.69'.

* 15 - 20 years ago.


I accept ed this as the best remaining evidence of this corner.

(c) (d) (e) Plan view of corner with ties to at least 4 witness monuments. If in disagreement with previously established corner, show the distances between the two corners and also indicate the ties to the disputed corner.

1. 2" x 30" Oneida County aluminum monument in mound of stone & earth, rod driven along side new monument.
2. 20" Red Pine, N80°E, 57.79'.
3. 10" White Birch, S28°E, 7.69'.
- *4. 6" Red Pine, S39°W, 24.65'.
- *5. 6" Red Pine, N85°W, 35.06'.
6. White Plastic sign post North, 1.0'.

*Scribed "1 1/4S BT".

Measurements from nail in side of BT's.

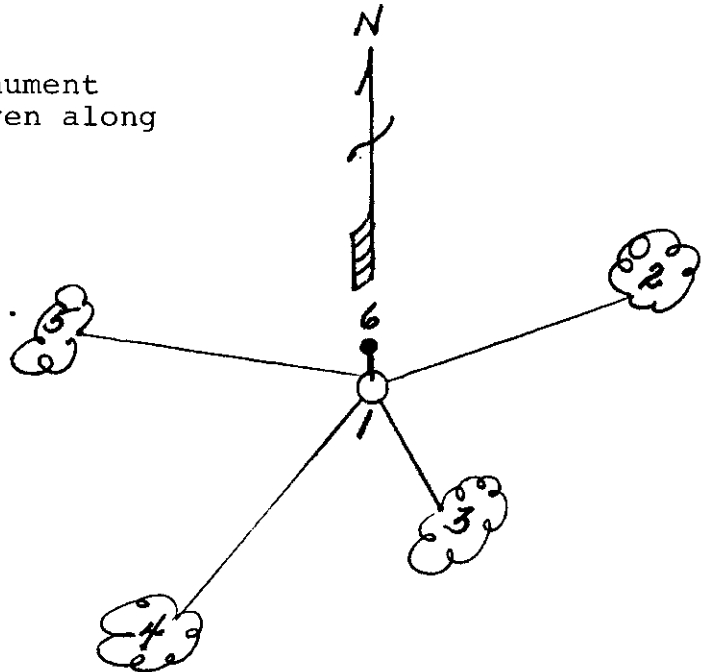

(i) I, Milo E. Stefan
(type or print name) certify that the corner location on this record was determined by me or under my direction and control and that this U.S. Public Land Survey Monument Record is correct and complete to the best of my knowledge and belief.

Milo E. Stefan
Signature

11/30/87
Date



Index No. A-23

3707240020