

CERTIFIED LAND CORNER RESTORATION

State of Wisconsin }  
County of Oneida } ss.

I William E. Bandow, do hereby certify that on the 7th day of February, 1979, I found evidence of the East corner of Section 21, Township 37 North, Range 7 East, Fourth Principal Meridian, as described hereon; and that from this evidence I established a new monument and accessories as described hereon to perpetuate the original location of this corner:

Description of original monument and accessories and subsequent restorations:

Corner set by Alfred Millard in Sept. 1860. North between 24 & 19. 40.00 set post. BT's  
Aspen 9" S13E 15 l.  
Maple 6" N16W 9 l.

Corner recovered by D.H. Vaughan in 1920.

Description of corner evidence found:

Brass capped iron pipe, three feet above ground.  
This corner set by Maine in 1936 to replace D.H. Vaughan's corner.


Description of monument and accessories I established to perpetuate the location of this corner:

Bearing tree's;

10" Oak, N 30° W 15.87'  
10" Aspen, N 83° W 16.76'  
14" Oak, S 40° E 16.05'



SEC. 24, T. 37N., R. 7 E.

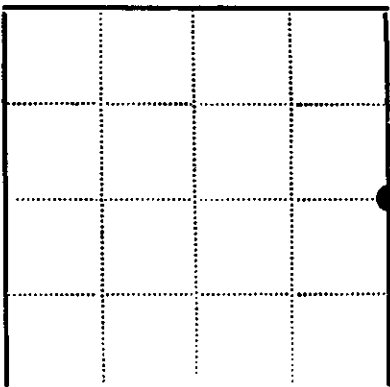

● - Corner monument restored  
□ -

Resident witnesses Mark Hendrickson, Mike Romportl

Dated at Rhinelander Wisconsin, this 17th day of October, 1980.

Signature William E. Bandow Title R.L.S.  
(County Surveyor, Registered Land Surveyor, or other duly authorized official)

Surveyors Registration No. 1182

Office of Register of Deeds County of Oneida

I hereby certify that the within instrument was filed in this office for record on the 11 day of June, 1980, and was filed in Book No. Page No. of County Records.

Signature Doris Verage Kuehn Title Register of Deeds  
Cynthia A. Pitts, Deputy

Township, Range, Section, Index No., Page No.

P. 25

3707242000