

U.S. PUBLIC LAND SURVEY MONUMENT RECORD


Note: This form is intended and designed to fulfill all requirements of Wisconsin Administrative Code, Chapter A-E 7.08 U.S. Public Land Survey Monument Record (3) (a) (b) (c) (d) (e) (f) (g) (h) (i). An additional sheet may be added if necessary to conform with said requirements.

(a) Corner location: Township 37 North

Range 7 East/West

Town/City/Village Cassian

County Oneida

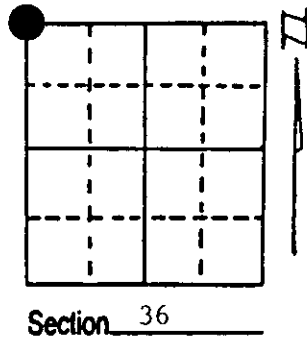

(b) (f) (g) (h) Description of monument found at this corner and if it was accepted, state all evidence (material, testimonial, occupational, plats, records, other monuments) used as a basis for accepting. If not accepted or if nothing was found, state evidence used as basis for establishing location. If reestablished through lost corner proportionate methods, indicate all monuments, distances and directions used to establish. Indicate type of monument found or set and sign post.

Nov. 1862 - Joseph H. Jenkins established this corner, set a wood post with 4 BTs:
 14" Red Pine, N62°W, 19 Links (12.54')
 15" Red Pine, S45°E, 38 Links (25.08')
 10" White Pine, N34°E, 13 Links (8.58')
 15" Red Pine, S26°W, 22 Links (14.52')


6/24/1936 - Vern Maine restored corner from remains of original BT remains and made three new BTs and set iron pipe monument:
 10" White Pine, N81°W, 44 Links (29.04')
 8" Red Pine, S10°W, 11½ Links (8.25')
 10" White Pine, S34°E, 56 Links (36.96') - Bearing in Error

6/11/1996 - Milo E. Stefan found Maine's monument in excellent condition and all his BTs alive. We made one new BT and set plastic sign post.

(c) (d) (e) Plan view of corner with ties to at least 4 witness monuments. If in disagreement with previously established corner, show the distances between the two corners and also indicate the ties to the disputed corner.

- 1) 2" x 60" iron pipe/B.C.
- 2) 18" White Pine, S40°E, 26.85'
- 3) 20" White Pine, S18°E, 37.30'
- 4) 10" Red Pine, S10°W, 8.26'
- 5) 24" White Pine, N81°W, 29.32'
- 6) Plastic Sign Post, North, 1.0'

Distances from nail in side of BTs
 Stump blaze scribed "BT"
 BT tags on face of each BT

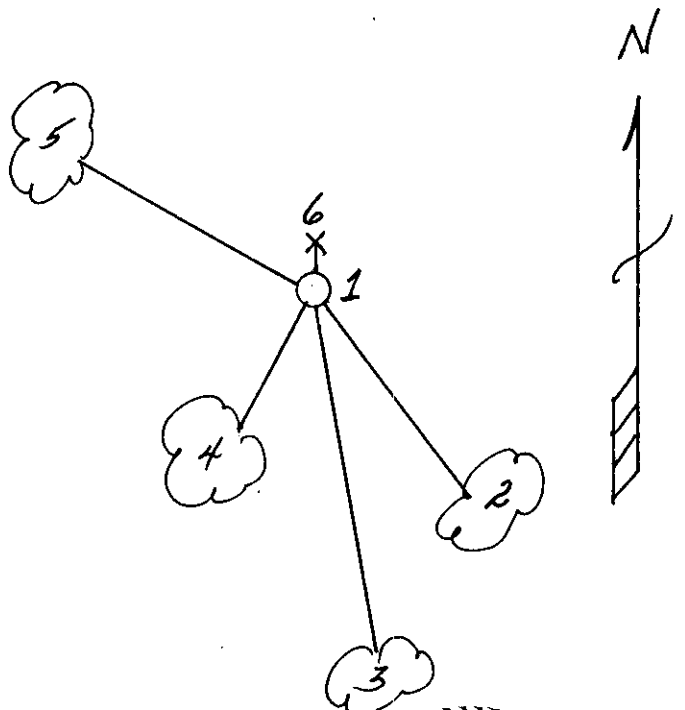

(i) I, Milo E. Stefan
 (type or print name) certify that the corner location on this record was determined by me or under my direction and control and that this U.S. Public Land Survey Monument Record is correct and complete to the best of my knowledge and belief.



Milo E. Stefan June 19, 1996
 Signature Date

Stamp
 37C 7260000

Index No. V-21