


# U.S. PUBLIC LAND SURVEY MONUMENT RECORD

**Note:** This form is intended and designed to fulfill all requirements of Wisconsin Administrative Code, Chapter A-E 7.08 U.S. Public Land Survey Monument Record (3) (a) (b) (c) (d) (e) (f) (g) (h) (i). An additional sheet may be added if necessary to conform with said requirements.

(a) Corner location: Township 37 North  
 Range 7 East/West

Town/City/Village Cassian

County Oneida

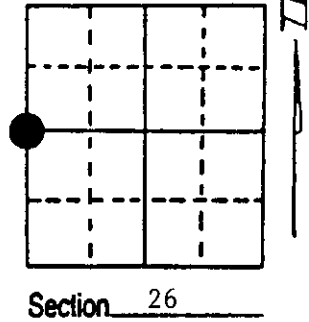

(b) (f) (g) (h) Description of monument found at this corner and if it was accepted, state all evidence (material, testimonial, occupational, plats, records, other monuments) used as a basis for accepting. If not accepted or if nothing was found, state evidence used as basis for establishing location. If reestablished through lost corner proportionate methods, indicate all monuments, distances and directions used to establish. Indicate type of monument found or set and sign post.

Nov. 1862 - Joseph H. Jenkins established this corner, set a wood post with two BTs:  
 12" Tamarack, S42°W, 20 Links (13.20')  
 8" Tamarack, S15°E, 12 Links (7.92')


7/1/1936 - Vern Maine restored corner from stumps of original BTs. He set an iron pipe/B.C. and made three BTs:  
 26" White Pine Stump, N30°E, 75 Links (49.50')  
 10" White Pine Stump, N88°E, 78½ Links (51.81')  
 14" Cedar Stub, N40°W, 30½ Links (20.13')

6/11/1996 - Milo E. Stefan found Maine's monument in excellent condition (10" in ground) and NE BT a very rotten stump, others gone.  
 We made four new BTs and set plastic sign post.

(c) (d) (e) Plan view of corner with ties to at least 4 witness monuments. If in disagreement with previously established corner, show the distances between the two corners and also indicate the ties to the disputed corner.

- 1) 2"x 60" iron pipe/B.C.
- 2) 6" Black Spruce, N25°E, 43.30'
- 3) 8" Black Spruce, S7°W, 57.52'
- 4) 8" Black Spruce, N59°W, 30.23'
- 5) 10" White Spruce, N19°W, 35.39'
- 6) Plastic Sign Post, North, 1.0'

Distances to nail in side of BTs  
 Stump blaze scribed "BT"  
 BT tags on face of each BT

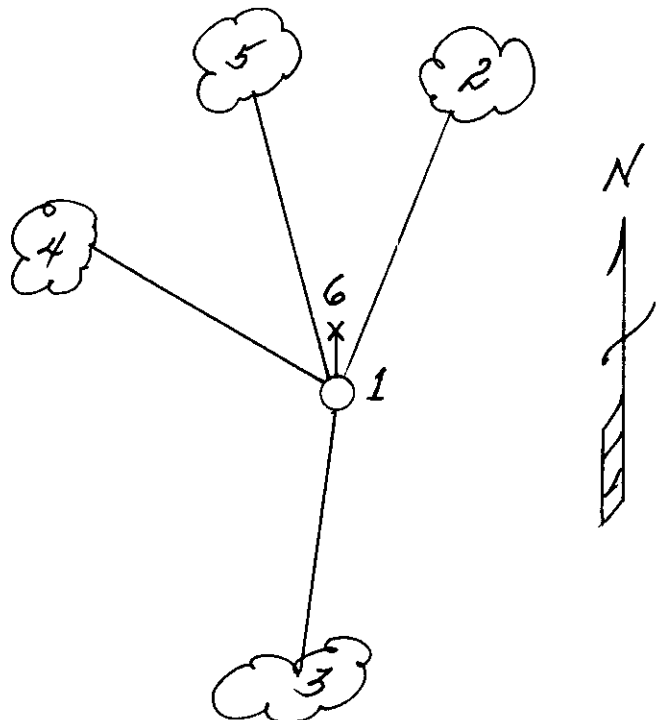

(i) I, Milo E. Stefan  
 (type or print name) certify that the corner location on this record was determined by me or under my direction and control and that this U.S. Public Land Survey Monument Record is correct and complete to the best of my knowledge and belief.

Milo E. Stefan  
 Signature

June 19, 1996  
 Date



Stamp  
 370727 2000