


# U.S. PUBLIC LAND SURVEY MONUMENT RECORD

**Note:** This form is intended and designed to fulfill all requirements of Wisconsin Administrative Code, Chapter A-E 7.08 U.S. Public Land Survey Monument Record (3) (a) (b) (c) (d) (e) (f) (g) (h) (i). An additional sheet may be added if necessary to conform with said requirements.

(a) Corner location: Township 37 North  
 Range 7 East/West  
 Town/City/Village Cassian  
 County Oneida

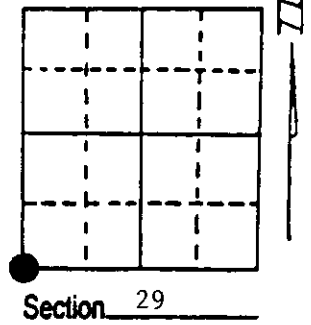

(b) (f) (g) (h) Description of monument found at this corner and if it was accepted, state all evidence (material, testimonial, occupational, plats, records, other monuments) used as a basis for accepting. If not accepted or if nothing was found, state evidence used as basis for establishing location. If reestablished through lost corner proportionate methods, indicate all monuments, distances and directions used to establish. Indicate type of monument found or set and sign post.

1862 - Joseph H. Jenkins established this corner, set post and BTs:  
 8" Maple, N16°E, 9 Links (5.94') 7" Birch, S72°E, 35 Links (23.10')  
 10" Birch, S73°W, 59 Links (38.94') 10" Birch, N44°W, 25 Links (16.50')


10/1/1968 - McNown called iron pipe/brass cap in survey of SE $\frac{1}{4}$ SE $\frac{1}{4}$  Section 30.

4/22/1993 - Milo E. Stefan found 2" iron pipe/brass cap.  
 Fence line North and East, poor state of maintenance.  
 18" White Pine BT, S45°W, 75.85'.  
 I accept this iron monument as the perpetuated Section Corner and restore same.

(c) (d) (e) Plan view of corner with ties to at least 4 witness monuments. If in disagreement with previously established corner, show the distances between the two corners and also indicate the ties to the disputed corner.

- 1) 2" x 24" high iron pipe/brass cap.
- 2) 20" Red Oak, S74°E, 25.38'.
- 3) 18" White Pine, S45°W, 75.85'.
- 4) 5" Red Maple, S42°E, 53.46'.
- 5) 16" Red Oak, N44°W, 51.86'.
- 6) Plastic sign post, South, 1.0'.


BTs stump blaze scribed "BT".  
 Distances from nail in side of BTs.

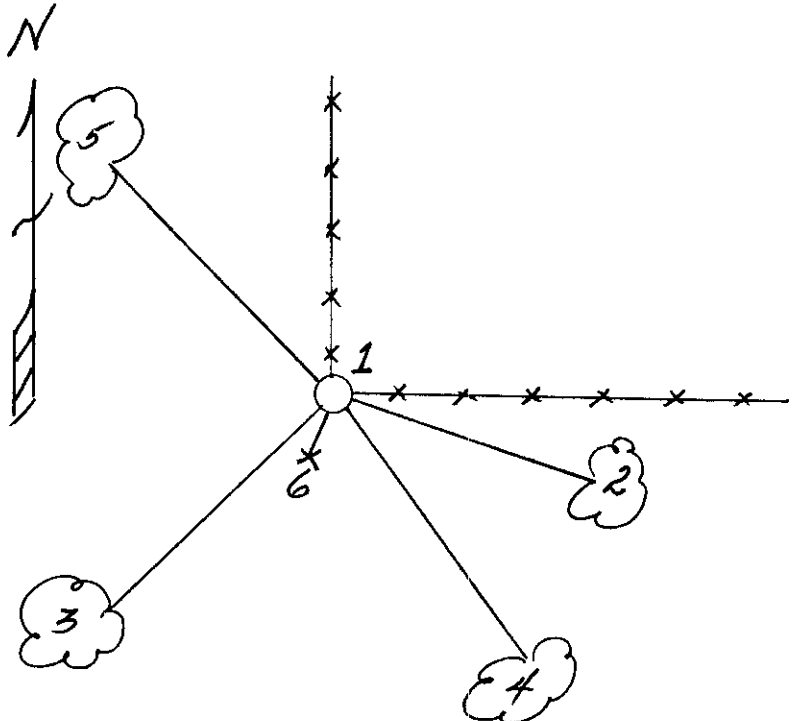

(i) I, Milo E. Stefan  
 (type or print name) certify that the corner location on this record was determined by me or under my direction and control and that this U.S. Public Land Survey Monument Record is correct and complete to the best of my knowledge and belief.

Milo E. Stefan  
 Signature

June 27, 1993  
 Date

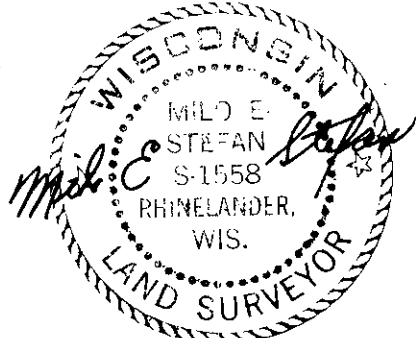

3707300000  
 Stamp

Index No. V-5