


# U.S. PUBLIC LAND SURVEY MONUMENT RECORD

Note: This form is intended and designed to fulfill all requirements of Wisconsin Administrative Code, Chapter A-E 7.08 U.S. Public Land Survey Monument Record (3) (a) (b) (c) (d) (e) (f) (g) (h) (i). An additional sheet may be added if necessary to conform with said requirements.

(a) Corner location: Township 36 North  
 Range 7 East West

Town/City/Village Woodboro

County Oneida

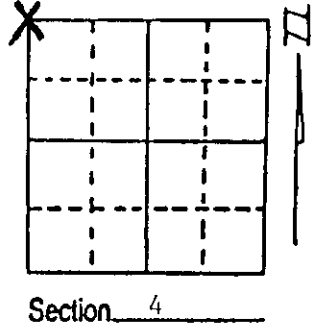

(b) (f) (g) (h) Description of monument found at this corner and if it was accepted, state all evidence (material, testimonial, occupational, plats, records, other monuments) used as a basis for accepting. If not accepted or if nothing was found, state evidence used as basis for establishing location. If re-established through lost corner proportionate methods, indicate all monuments, distances and directions used to establish. Indicate type of monument found or set and sign post.

1860 - Alfred Millard established corner at 80.00 chains and set a wood post:  
 10" W. Pine, N48°E, 11 links                      16" W. Pine, S71°W, 34 links  
 12" Hemlock, S55°E, 17 links                      18" W. Pine, N19°W, 62 links

2/25/1989 - Milo E. Stefan found corner marked by an iron pipe 1 1/4" x 24" in mound of stone. Also, a scribed cedar post along side. This is supported by the remains of the stump of the original 18" White Pine at N19°W, 62 links.  
 I accept this iron pipe as the perpetuated position of the original corner location and placed a county aluminum monument.


(c) (d) (e) Plan view of corner with ties to at least 4 witness monuments. If in disagreement with previously established corner, show the distances between the two corners and also indicate the ties to the disputed corner.

1. 2" x 30" aluminum monument in mound of stone
- \*2. 7" Sugar Maple, N70°E, 8.68' (BT face overgrown)
3. 12" Sugar Maple, S12°W, 19.57'
4. 8" Sugar Maple, N81°W, 39.55'
5. 10" Red Oak, N16°W, 36.50'
6. Plastic sign post tied to cedar post

\*Old BT

Distances to nail in side of tree

BT's scribed in stump blaze "BT"

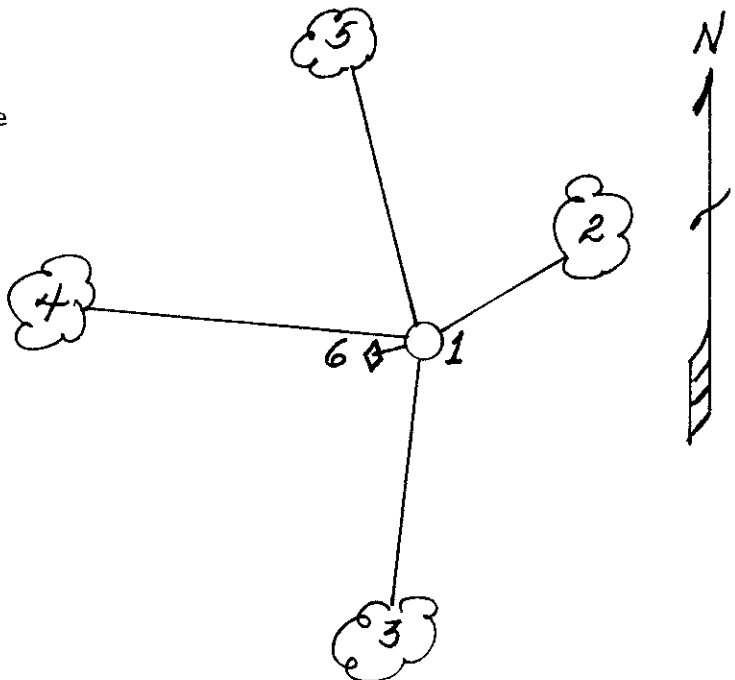

(i) I, Milo E. Stefan  
 (type or print name) certify that the corner location on this record was determined by me or under my direction and control and that this U.S. Public Land Survey Monument Record is correct and complete to the best of my knowledge and belief.

Milo E. Stefan  
 Signature

March 10, 1989  
 Date



Index No. A-9

3707320000