


CERTIFIED LAND CORNER RESTORATION

State of Wisconsin }  
County of Oneida } ss.

I Jean F. Resvick, do hereby certify that on the 29th day of Sept., 1981, I found evidence of the west Meander corner ~~at~~ on the north line of Sec. 5 Township 36 North, Range 7 East, Fourth Principal Meridian, as described hereon; and that from this evidence I established a new monument and accessories as described hereon to perpetuate the original location of this corner:

Description of original monument and accessories and subsequent restorations:

- Surveyed in 1860 by Alfred Millard.
- west between sections 29 and 32
- 40.00 chains sec.  $\frac{1}{4}$  post
- 40.98 chains small lake
- 45.47 chains over lake, set meander post
- Tamarack 5, N 3 W, 28 lks
- Tamarack 5, S 64 W, 47 lks
- 46.50 chains leave swamp bears N & S
- 80.00 chains sec. corner

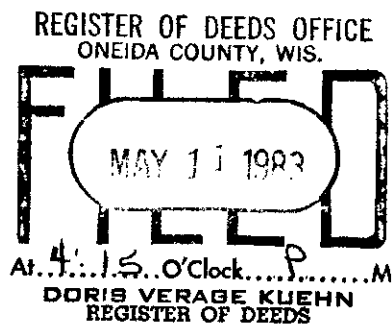

Description of corner evidence found:

Set a point 361.02 feet east of North Quarter corner of Section 5, and on line between the Quarter corner and the Northwest section corner. Point set is located on the west shore of 3-Day lake remains of Tamarack stump found at N. 3 W., 10.5 feet from point sec. Edge of swamp west, 100 links


Description of monument and accessories I established to perpetuate the location of this corner:

Point as set not monumentable. I set a Witness Meander corner 66 feet west on the section line. Set a 2 inch diameter aluminum county monument stamped to identify witness corner. Witness corner set on solid ground at edge of swamp from which the following bearing trees bear:  
Balsam 5", N. 31., 21.94 feet  
Balsam 7", S. 29 W., 89.14 feet  
White Birch 6", N. 73., 26.41 feet  
Distances measured to 1/16 penny, galvanized nail set in side of tree.

Compared with record data & accepted as correct.

*Robert H. Kinak*

Oneida County Surveyor 27 Apr 1983

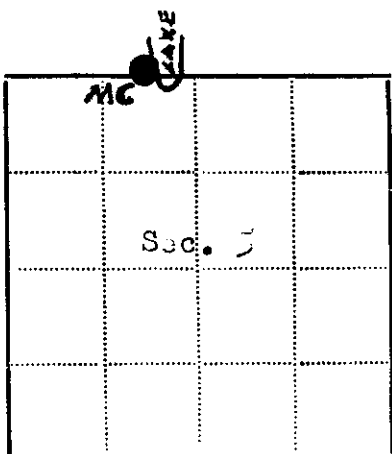

- - Corner monument restored
- -

Resident witnesses.....

Dated at Rhineland Wisconsin, this 29 day of Sept. 1981.

Signature *Jean F. Resvick* Title C.L.S.  
(County Surveyor, Registered Land Surveyor, or other duly authorized official)

Surveyors Registration No. S-802

Office of..... County of.....

I hereby certify that the within instrument was filed in this office for record on the..... day of..... 19....., and was filed in Book No..... Page No..... of County Records.

Signature..... Title.....

Township 36 North, Range 7 East, Section 5, Index No..... Page No.....

3707320025

A-542