


U.S. PUBLIC LAND SURVEY MONUMENT RECORD

Note: This form is intended and designed to fulfill all requirements of Wisconsin Administrative Code, Chapter A-E 7.08 U.S. Public Land Survey Monument Record (3) (a) (b) (c) (d) (e) (f) (g) (h) (i). An additional sheet may be added if necessary to conform with said requirements.

(a) Corner location: Township 36 North
 Range 7 East/West

Town/City/Village Woodboro
 County Oneida

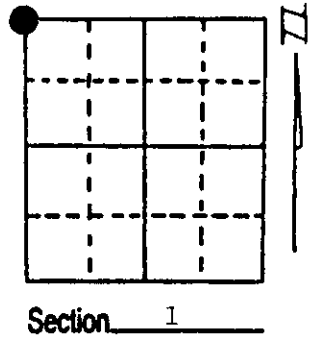


(b) (f) (g) (h) Description of monument found at this corner and if it was accepted, state all evidence (material, testimonial, occupational, plats, records, other monuments) used as a basis for accepting. If not accepted or if nothing was found, state evidence used as basis for establishing location. If reestablished through lost corner proportionate methods, indicate all monuments, distances and directions used to establish. Indicate type of monument found or set and sign post.

- Sept. 1860 - Alfred Millard established this corner and set a wood post with four BTs:
 24" White Pine, N83°E, 15 Links (9.90')
 20" Black Oak, S45°W, 2 Links (1.32')
 6" Maple, S60°E, 39 Links (25.74')
 20" Red Pine, N54°W, 54 Links (35.64')
- 6/3/1936 - Vern Maine found stumps of both Pine BTs nearly burnt up. He set a county monument with two BTs:
 3" Black Oak, S60°W, 37 1/2 Links (24.75')
 24" White Pine Stump, North, 52 1/2 Links (34.65')
- 6/25/1996 - Milo E. Stefan found Maine's monument in good condition. We made new BTs and set plastic sign post.

(c) (d) (e) Plan view of corner with ties to at least 4 witness monuments. If in disagreement with previously established corner, show the distances between the two corners and also indicate the ties to the disputed corner.

- 1) 2" x 60" Iron Pipe/Brass Cap.
- 2) 4" Red Oak, N30°E, 23.05'.
- 3) 6" Aspen, S42°E, 46.01'.
- 4) 3" Red Oak, S69°W, 30.60'.
- 5) 13" Red Oak, N82°W, 42.55'.
- 6) Plastic Sign Post, North, 1.4'.

Distances from nail in side of BTs.
 Stump blaze scribed "BT".
 BT tags nailed to face of each BT.

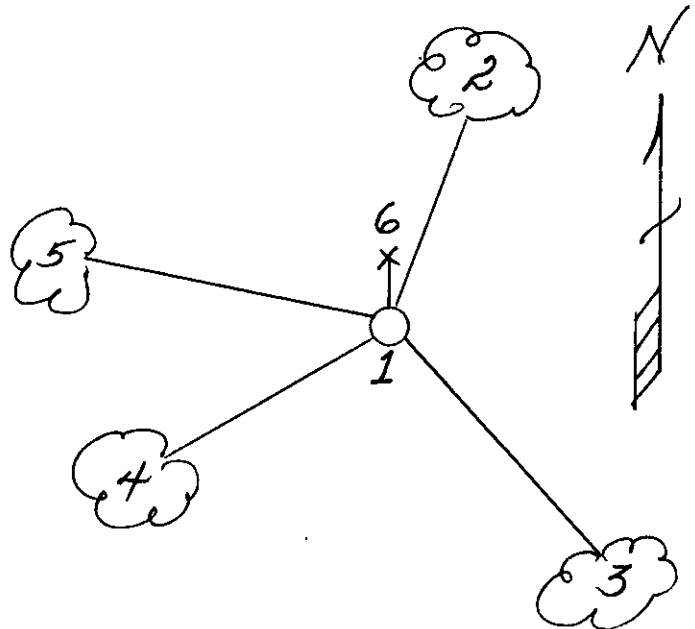

REGISTER OF DEEDS OFFICE
 ONEIDA COUNTY, WIS.
FILED
 SEP - 4 1996
 At _____ O'Clock _____ M
THOMAS H. LEIGHTON
 REGISTER OF DEEDS

(i) I, Milo E. Stefan
 (type or print name) certify that the corner location on this record was determined by me or under my direction and control and that this U.S. Public Land Survey Monument Record is correct and complete to the best of my knowledge and belief.

Milo E. Stefan August 17, 1996
 Signature Date



Stamp
 3707350000