

CERTIFIED LAND CORNER RESTORATION

Index No. **E-1**

State of Wisconsin

County of Oneida } ss.



I Philip T. Hansen, do hereby certify that on the 23rd day of March 1977, I found evidence of the Section corner of Sec. 1, 6, 12, 7 Township 37 North, Range 8-9 East, Fourth Principal Meridian,

as described hereon; and that from this evidence I established a new monument and accessories as described hereon to perpetuate the original location of this corner.

Resident witnesses:

Jim Clarlin

Herb Wagoner

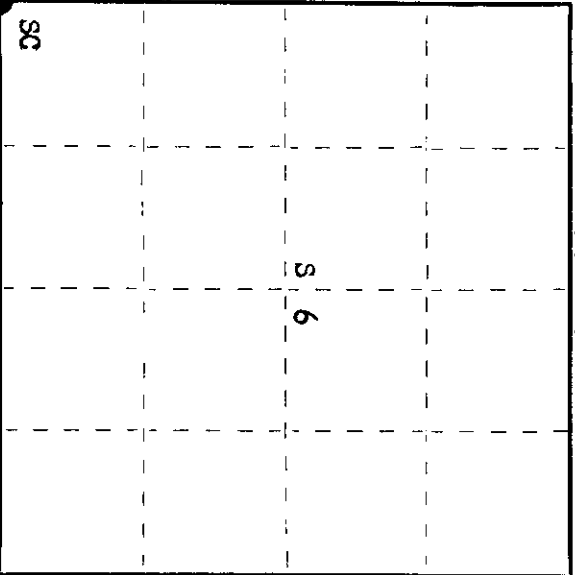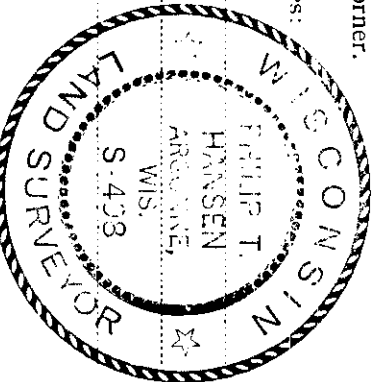

○ = Corner monument restored.

History of original corner establishment:

Original Corner established by H.C. Fellows, Deputy Surveyor, in 1860 from which Birch 8" bears S 43° W, 85 links; Tamarack 6" bears N 72° W, 110 links; Yellow Pine 12" bears N 24° E, 193 links; Birch 8" bears S 28° E, 118 links. Corner recovered and restored by D.H. Vaughan, County Surveyor. Corner recovered by N. Loftus, Ripco Surveyor, in 1960. No record of BFs established.

Description of corner evidence found:

Recovered 2" iron pipe with 4" square brass cap in good condition. Monument projects 12" above ground, cap stamped: Recovered White Pine 32" S48°W 112.2 links, scribed S12 BT. White Pine 24" S4°E 104.5 links, scribed S7 BT.

T 37 T 37  
N S1 S6 N  
R S12 S7 R  
8 RIPC 9 E

Description of monument and accessories I established to perpetuate the original location of this corner. As the corner was recovered in good condition and securely in ground, it was left as recovered. This corner sets in a small open bog. No additional accessories established.

Dated at Rhineland, Wis., this 28th day of March, 1977

Signature Philip T. Hansen Title Registered Land Surveyor Registration No. S-498  
(County Surveyor, Registered Land Surveyor, or other duly authorized official)

Office of Register of Deeds, County of Oneida. I hereby certify that the within instrument was filed in this office for record on the 1st day of April, 1977 at 10 o'clock P. M.

Carole A. Wagner  
(Register of Deeds)

By: \_\_\_\_\_ Deputy

3708010000