

CERTIFIED LAND CORNER RESTORATION

Index No. **E-23**

History of original corner establishment:

Original corner established by Wm. E. Dougherty, Deputy Surveyor, in 1863, from which Plr 10' bears S73°E, 10 links and Cedar 10' bears N26°W, 16 links.

N. Loftus, Ripco surveyor, ran a random line west from NE corner, bearing S88° 30' West and closed out 1.42 chains south of NW corner.

Set N 1/4 corner at 71 links north at 41.765 chains equidistant, marked NBTs. - No records.

Description of corner evidence found:

Recovered 1 1/2" iron pipe with 4" square, buried in the muck. A 4" square cedar post, not scribed, setting beside it.

Recovered OBTs - Cedar 7" S69°E, 19 links, scribed 1/4 S12 - T37 - R8E BT.  
Cedar 6" N2°E, 19.0 links, scribed S1 1/4 T37 R8E.

The iron pipe was badly rusted.

Description of monument and accessories I established to perpetuate the original location of this corner.

Set new A-1 Federal Monument (Bernitsen with magnet in cap and base). Cap stamped:  
Marked NBT - Cedar 7" N74°E, 33.7 links, scribed 1/4 BT.

T37N R8E  
1/4 S 1/4  
S498-1977

State of Wisconsin

County of Oneida } ss.

I Phillip T. Hansen do hereby certify that on the 6th day of May, 1977, I found evidence of the Quarter corner of Section 1 & 12



Township 37, North, Range 8 East, Fourth Principal Meridian.

I established a new monument and accessories as described hereon to perpetuate the original location of this corner.

Resident witnesses:

Jrn Graflin

Herb Wagoner

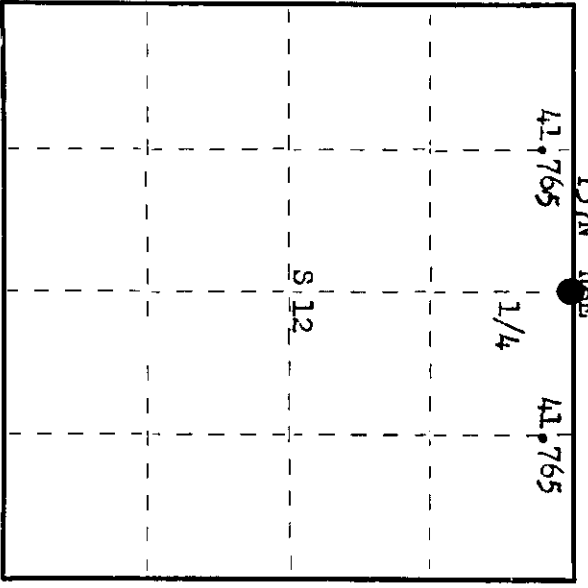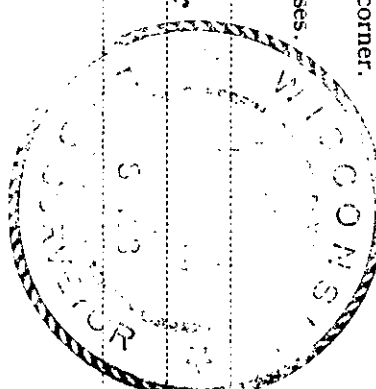

○ = Corner monument restored.

Dated at Rhinelander, Wis. this 10th day of May, 1977.

Signature: Phillip T. Hansen Title: Registered Land Surveyor Registration No. S-498  
(County Surveyor, Registered Land Surveyor, or other duly authorized official)

Office of Register of Deeds, County of Oneida. I hereby certify that the within instrument was filed in this office for record on the 16th day of May, 1977, at 10:30 o'clock A. M.

Doreen George Kaska  
(Register of Deeds)

By: \_\_\_\_\_ Deputy

37080/0020