

CERTIFIED LAND CORNER RESTORATION

Index No. **D-23**

State of Wisconsin

County of Oneida } ss.

I Phillip T. Hansen, do hereby certify that on the 19th day of April, 1977, I found evidence of the SC 1/16



corner of Section 1, Township 37, North, Range 8 East, Fourth Principal Meridian,

as described hereon; and that from this evidence I established a new monument and accessories as described hereon to perpetuate the original location of this corner.

Resident witnesses:

Jim Claflin

Herb Wagoner

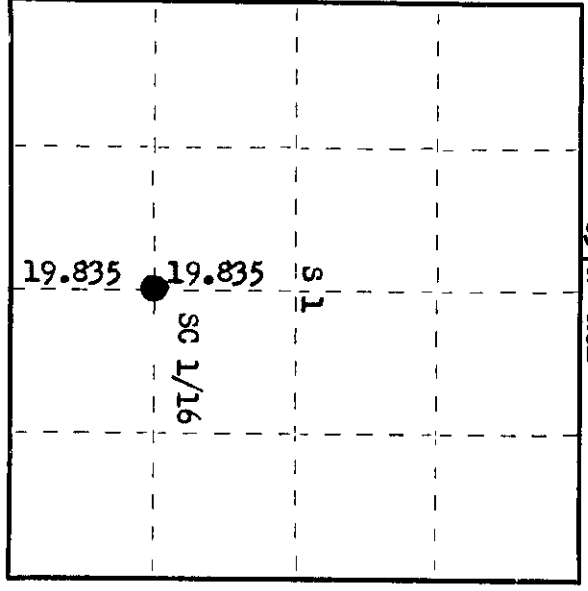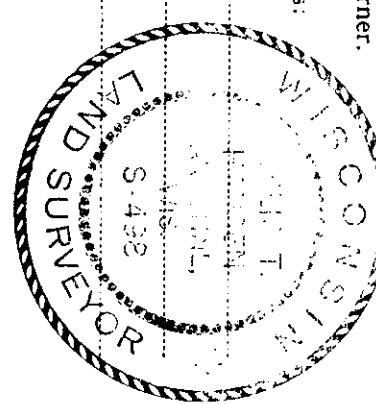

○ = Corner monument restored.

History of original corner establishment:

Corner established by N. Loftus, Ripco Surveyor, in 1960. Ran random line 174° 30' mag. from N 1/4 corner 77.07 chains to close out 7 links west of S 1/4 corner. Corrected bearing S 0° 33' E. Ran random line East from W 1/4 corner, 90° 07' mag. 81.86 chains to close out 1.89 chains south of E 1/4 corner. Corrected line to establish C 1/4 corner at 39.67 chains North 0° 33' West of S 1/4 corner. Set SC 1/16 at 19.835 chains intermediate.

Marked NBTs - Sugar 5" S 17° W, 36 links.
Cedar 12" S 70° W, 25 1/2 links.

Description of corner evidence found:

Recovered 5" square cedar post, scribed GS 1/16 S1 in very good condition. This sets 20 links east of the center line of woods road.

Recovered OBTs - Sugar 5" (6") S17° W, 36.0 links, scribing not legible.
Cedar 12" S70° W, 25.5 links, scribed SC 1/16 S1.

Description of monument and accessories I established to perpetuate the original location of this corner.

Replaced wood post with 1" x 18" iron pipe driven in post hole flush with the ground. Set a 1" iron pipe with 2" brass cap for witness corner, 45 links east of true corner. Monument projects 2 1/4" above ground. Cap stamped:

NBT - Hemlock 10" N6° E, 45.6 links, scribed 1/16 BF.
T37N R8E S498
SC 1/16 S 1 W.C.
W-45 lks.

Dated at Rhineland, Wis., this 3rd day of May, 1977.

Signature Phillip T. Hansen Title Registered Land Surveyor Registration No. S-498
(County Surveyor, Registered Land Surveyor, or other duly authorized official)

Office of Register of Deeds, County of Oneida. I hereby certify that the within instrument was filed in this office for record on the 5th day of May, 1977 at 2:00 o'clock P. M.

Terrie W. Hager Kassahn
(Register of Deeds)

By: _____ Deputy

020108073