

U.S. PUBLIC LAND SURVEY MONUMENT RECORD


Note: This form is intended and designed to fulfill all requirements of Wisconsin Administrative Code, Chapter A-E 5.02, U.S. Public Land Survey Monument Record (3) (a) (b) (c) (d) (e) (f) (g) (h) (i). An additional sheet may be added if necessary to conform with said requirements.

(a) Corner location: Township 37 North

Range 8 East West

Town/City/Village Pine Lake

County Oneida

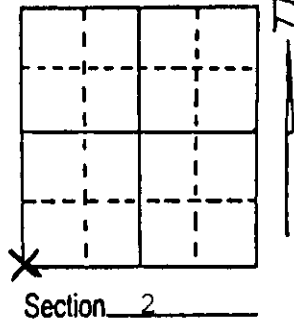

(b) (f) (g) (h) Description of monument found at this corner and if it was accepted, state all evidence (material, testimonial, occupational, plats, records, other monuments) used as a basis for accepting. If not accepted or if nothing was found, state evidence used as basis for establishing location. If reestablished through lost corner proportionate methods, indicate all monuments, distances and directions used to establish.

July 1863, Wm. E. Daugherty at 80.00 chains set post for section corner:
 8" Jack Pine, N52°E, 4 links (2.64')
 8" Jack Pine, S23°W, 24 links (15.84')
 April 1977, N. Loftus found evidence of old corner and placed a "RIPCO" monument. 1 1/4" iron pipe with brass cap stamped to identify corner. County survey map # C-347.
 February 3, 1988, Milo E. Stefan found corner set by Loftus and tied it off.

(c) (d) (e) Plan view of corner with ties to at least 4 witness monuments. If in disagreement with previously established corner, show the distances between the two corners and also indicate the ties to the disputed corner.


1. 1 1/4" iron pipe with brass cap 1/4" x 3" x 3"
2. 16" Red Pine, N4°E, 87.22'
3. 4" Red Pine, S69°E, 99.89' *
4. 6" Red Maple, S12°E, 33.24'
5. 14" White Pine, N73°W, 72.95'
6. Plastic sign post, SW, 1.7'

Distances measured to nail in side of trees.

Trees scribed "T37N, R8E, S-BT"

*Tree scribed "X BT"

Monument is on top of cut bank for ditch of river road.

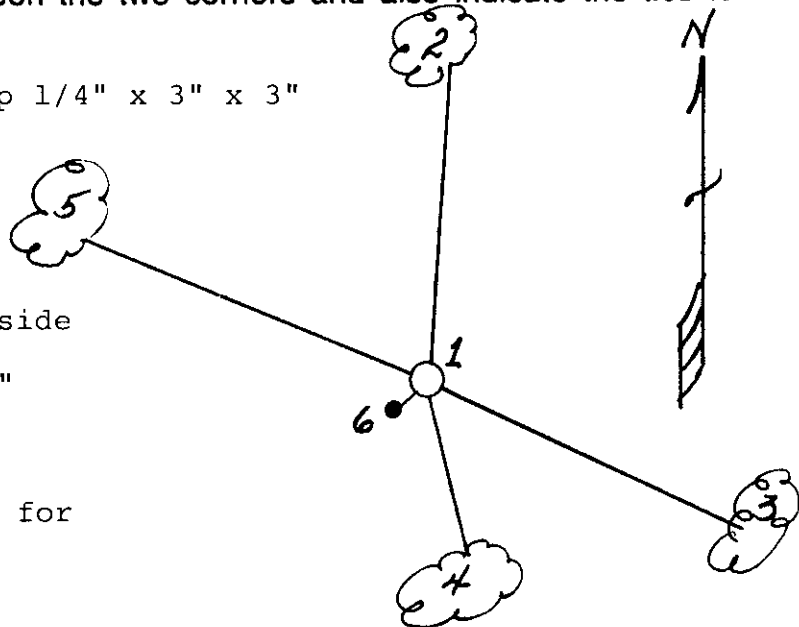

(i) I, Milo E. Stefan
 (type or print name) certify that the corner location on this record was determined by me or under my direction and control and that this U.S. Public Land Survey Monument Record is correct and complete to the best of my knowledge and belief.

Milo E. Stefan
 Signature

2/24/88
 Date



Index No. E-17

3708030000