



CERTIFIED LAND CORNER RESTORATION

State of Wisconsin }  
County of Oneida } ss.

I, Michael J. Romportl, do hereby certify that on the 16<sup>th</sup> day of October, 1981, I found evidence of the southwest corner of Section 3 Township 37 North, Range 3 East, Fourth Principal Meridian, as described hereon; and that from this evidence I established a new monument and accessories as described hereon to perpetuate the original location of this corner:

Description of original monument and accessories and subsequent restorations:



- 1863 Wm. E. Daugherty set org. cor E.T.S J. Pine 15 N 54° E 231ks.; J. Pine S 48° W 151ks.
- 1905 D.H. Vaughan fd. org. stumps of E.T.S set post and remarked E.T.S, he was running line north & east for road (34.55 ch. North, lake)
- Oct. 1961 Ivan Iranham fd. iron pipe buried in rd. with E.T.S checked dist. to lake agreed with Vaughan
- July 1973 Lester Schmit fd. iron pipe E.T.S W. Birch S 5° 30' W 37.20' 12" ; J. Pine 15" N 60° E 56.90'
- 1977 Todd Loftus tied to cor for S.S.M. 712
- 1961 J.C. Kirby at cor. J. Pine 15" N 60° E 56.90'

Description of corner evidence found:

- 8d. 1 1/2" iron pipe below surface of gravel rd.
- 8d. 1 1/2" Birch S 9° W 37.3'
- 8d. 1 1/2" J. pine N 63° E 56.8'

Description of monument and accessories I established to perpetuate the location of this corner:

- iron pipe in good condition made the following witnesses
- clump of 3 maples 6" N 74° W 79.77'
- 1 1/2" iron pipe N 30° W 92.93'
- 1 1/2" iron pipe N 84° E 116.01'
- \* magnetic bearings
- \* measured to P.M. nail in face of blaze
- \* cor. is at the intersection of a private rd. to the west and River Road bearing north & east

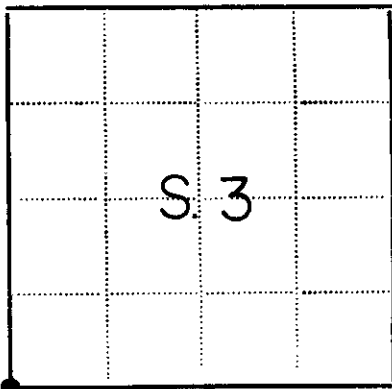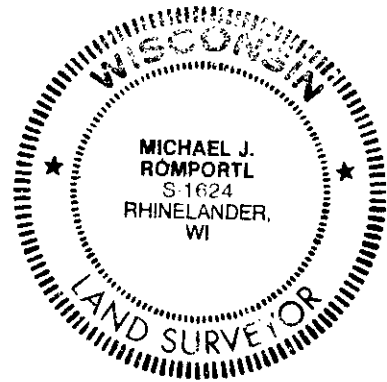

● - Corner monument restored  
□ -

Resident witnesses.....

Dated at Rhineland Wisconsin, this 5<sup>th</sup> day of November, 1981.

Signature Michael J. Romportl Title Registered Land Surveyor  
(County Surveyor, Registered Land Surveyor, or other duly authorized official)

Surveyors Registration No. 1624

Office of Register of Deeds County of Oneida

I hereby certify that the within instrument was filed in this office for record on the 11 day of June, 1986, and was filed in Book No. Page No. of County Records.

Signature Doris Verage Kuehn Title Reg. of Deeds  
Cynthia A. Pitts, Deputy

Township....., Range....., Section....., Index No....., Page No.....