U.S. PUBLIC LAND SURVEY MONUMENT RECORD

Note: This form is intended and designed to fulfill all requirements of Wisconsin Administrative Code, Chapter A-E 5.02, U.S. Public Land Survey Monument Record (3) (a) (b) (c) (d) (e) (f) (g) (h) (i). An additional sheet may be added if necessary to conform with said requirements.

(a) Corner location: Township 37 North

Range 8 East/~~West~~

Town/~~City/Village~~ Pine Lake

County Oneida

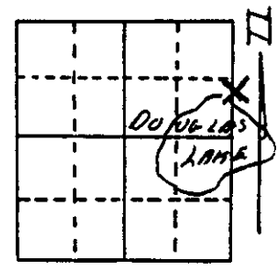

Section 4

(b) (f) (g) (h) Description of monument found at this corner and if it was accepted, state all evidence (material, testimonial, occupational, plats, records, other monuments) used as a basis for accepting. If not accepted or if nothing was found, state evidence used as basis for establishing location. If reestablished through lost corner proportionate methods, indicate all monuments, distances and directions used to establish.

July 1863, Wm. E. Daugherty set wood post for M.C. on north side of lake and made a BT:
12" Red Pine, N25°W, 90 links (59.40')
5/15/1905 Vaughn found stump of original BT and made a new BT:
12" Red Pine, N3°W, 79 1/2 links (52.47')
4/13/63 Wincentsen found Vaughn corner and placed an iron pipe and 2 BTs:
6" Red Pine, N20°W, 49.4'
4" Red Maple, N68°W, 82.6'
2/19/88 Milo E. Stefan found 18" Red Pine snag 6' high with blaze scribed nearly grown over. Scribing plain. Thought to be Vaughn's 1905 BT. From this BT, a hole in bog at edge of lake. Could not locate iron pipe. Placed new county cap in hole and made new BTs.

(c) (d) (e) Plan view of corner with ties to at least 4 witness monuments. If in disagreement with previously established corner, show the distances between the two corners and also indicate the ties to the disputed corner.

1. 2" x 30" Oneida County aluminum monument
2. 4" Red Pine, N3°E, 70.13' (X BT)
3. 3" Tamarack, N36°E, 74.35' (X BT)
4. 8" Red Maple, N62°W, 80.27' (S5 MC BT)
   (Maybe progeny of Wincentsen BT)
5. 5" White Pine, N31°W, 95.25' (X BT)
6. 18" Red Pine snag, N3°W, 52.5'
7. Plastic sign post, next to monument

Measurements to nail in side of tree.
(Indicates scribing done at this time.)

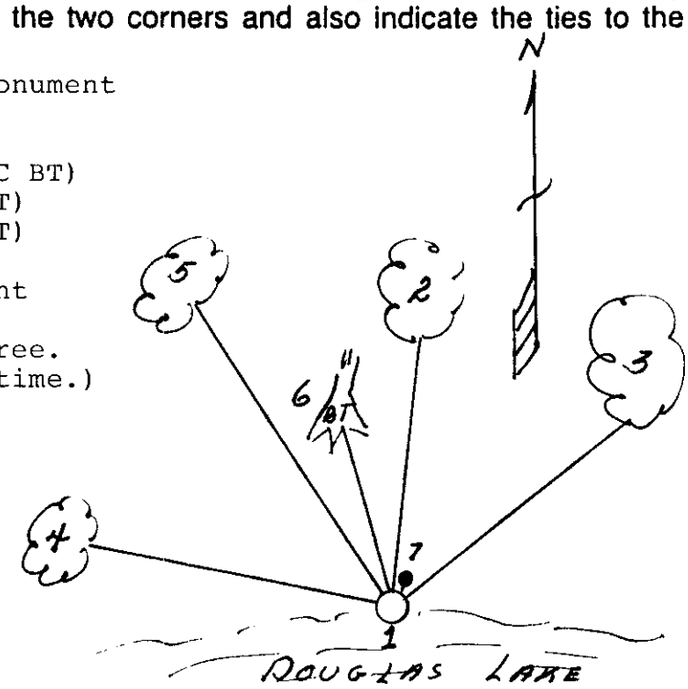

(i) I, Milo E. Stefan (type or print name) certify that the corner location on this record was determined by me or under my direction and control and that this U.S. Public Land Survey Monument Record is correct and complete to the best of my knowledge and belief.

Milo E Stefan 2/26/88

Signature Date

WISCONSIN MILO E. STEFAN S-1558 RHINELANDER, WIS. LAND SURVEYOR

Index No. BC-13

3708042.906