


# U.S. PUBLIC LAND SURVEY MONUMENT RECORD

**Note:** This form is intended and designed to fulfill all requirements of Wisconsin Administrative Code, Chapter A-E 7.08 U.S. Public Land Survey Monument Record (3) (a) (b) (c) (d) (e) (f) (g) (h) (i). An additional sheet may be added if necessary to conform with said requirements.

(a) Corner location: Township 37 North  
 Range 8 East/West

Town/City/Village Newbold  
 County Oneida

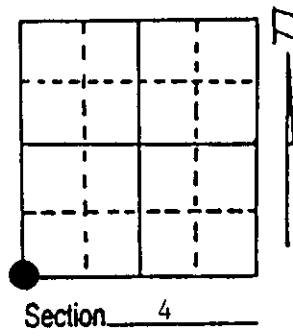

(b) (f) (g) (h) Description of monument found at this corner and if it was accepted, state all evidence (material, testimonial, occupational, plats, records, other monuments) used as a basis for accepting. If not accepted or if nothing was found, state evidence used as basis for establishing location. If reestablished through lost corner proportionate methods, indicate all monuments, distances and directions used to establish. Indicate type of monument found or set and sign post.

1863 - William Daugherty established this corner and set a wood post with BTs:  
 10" Y. Pine, N53°E, 19 Links                      10" Y. Pine, S46°W, 9 Links


Unknown Date - RIPCO restored corner from original BT N53°E, 12.5' (scribed face plain on tipped out fallen snag). Southwest BT gone but stump hole plain. They placed 3" x 3" brass cap on 18" high 1 1/2" iron pipe. 16" Red Pine BT by RIPCO blown down, S10°W, about 14'.

8/1/1989 - Milo E. Stefan found RIPCO cap in good condition. I accept the monumented position as supported by the original BT and made new BTs and placed a plastic sign post.

(c) (d) (e) Plan view of corner with ties to at least 4 witness monuments. If in disagreement with previously established corner, show the distances between the two corners and also indicate the ties to the disputed corner.

- 1) 3" x 3" x 18" high RIPCO Monument.
- 2) 16" Red Pine, N21°E, 74.02'
- 3) 20" Red Pine, S72°E, 59.02'
- 4) 6" Red Maple, S31°W, 30.82'
- 5) 8" Red Maple, N44°W, 23.75'
- 6) Plastic sign post, North, 1.0'

Distances to nail in side of BT.  
 BTs scribed "BT" in stump blaze.

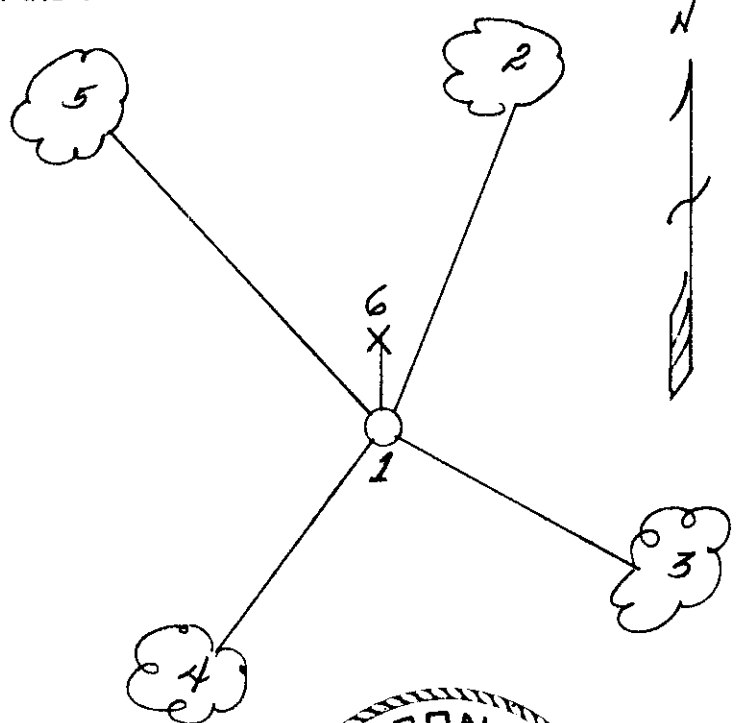

(i) I, Milo E. Stefan  
 (type or print name) certify that the corner location on this record was determined by me or under my direction and control and that this U.S. Public Land Survey Monument Record is correct and complete to the best of my knowledge and belief.

Milo E Stefan  
 Signature

8/5/89  
 Date



Index No. E-9

3708050000