U.S. PUBLIC LAND SURVEY MONUMENT RECORD

Note: This form is intended and designed to fulfill all requirements of Wisconsin Administrative Code, Chapter A-E 5.02, U.S. Public Land Survey Monument Record (3) (a) (b) (c) (d) (e) (f) (g) (h) (i). An additional sheet may be added if necessary to conform with said requirements.

(a) Corner location: Township 37 North

Range 8 East/~~West~~

Town/~~City/Village~~ Newbold

County Oneida

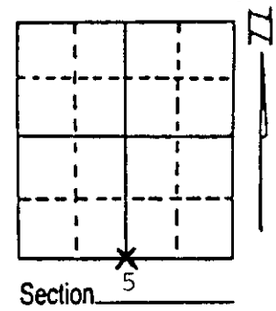

(b) (f) (g) (h) Description of monument found at this corner and if it was accepted, state all evidence (material, testimonial, occupational, plats, records, other monuments) used as a basis for accepting. If not accepted or if nothing was found, state evidence used as basis for establishing location. If reestablished through lost corner proportionate methods, indicate all monuments, distances and directions used to establish.

July 1863, Wm. E. Daugherty; at 39.84 chains set 1/4 section post:
12" Elm, S34°E, 43 links (28.38')
10" Maple, N11°E, 17 links (11.22')
February 17, 1954, F. R. Wincentsen restored this corner and placed an iron pipe with two new BT's:
10" Tamarack, N80°E, 8.5 links (5.61')
4" Tamarack, S21°E, 25.5 links (16.83')
February 3, 1988, Milo E. Stefan found Wincentsen iron pipe 1" x 48", 6" in ice supported by rotted and fallen 10" Tamarack scribed, N80°E, 5.6' and 5" Tamarack stub, 36" high, scribed S21°E, 16.8'. Area in beaver flowage, timber dead for 500' - 600' North 100' - 200' South, East and West.

(c) (d) (e) Plan view of corner with ties to at least 4 witness monuments. If in disagreement with previously established corner, show the distances between the two corners and also indicate the ties to the disputed corner.

1. 2" x 30" Oneida County aluminum monument, over iron pipe, 1" x 48".
2. 4" Black Spruce, S23°E, 112.23'
3. 4" White Oak, S19°W, 173.02'
4. 12" White Birch, S62°W, 216.75'
5. Plastic sign post

Distances to nail in side of trees, measured with E.D.M.
Trees scribed "1/4S BT"

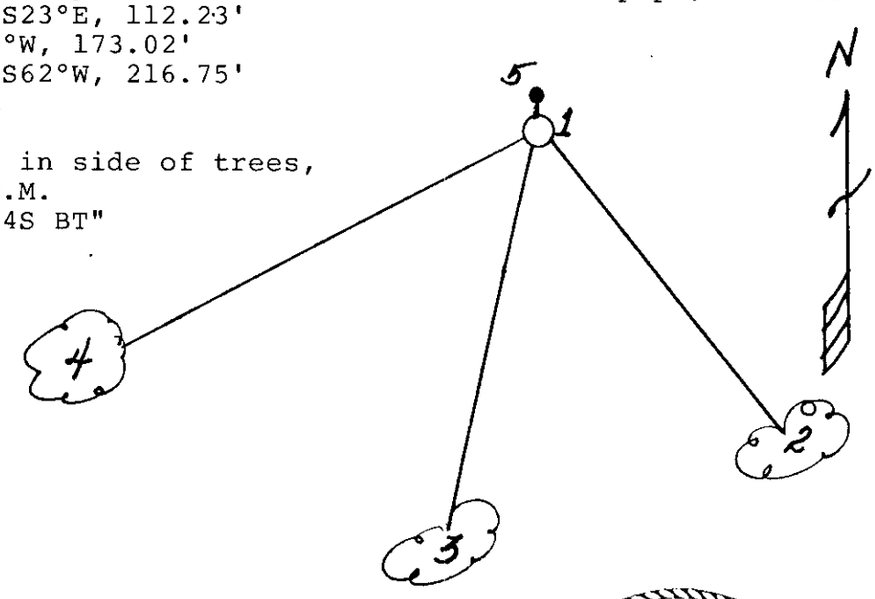

(i) I, Milo E. Stefan (type or print name) certify that the corner location on this record was determined by me or under my direction and control and that this U.S. Public Land Survey Monument Record is correct and complete to the best of my knowledge and belief.

Milo E. Stefan — Signature

2/24/88 — Date

WISCONSIN MILO E. STEFAN S-1653 RHINELANDER, WIS. LAND SURVEYOR

Index No. F-7

37C8050020