

U.S. PUBLIC LAND SURVEY MONUMENT RECORD


Note: This form is intended and designed to fulfill all requirements of Wisconsin Administrative Code, Chapter A-E 5.02, U.S. Public Land Survey Monument Record (3) (a) (b) (c) (d) (e) (f) (g) (h) (i). An additional sheet may be added if necessary to conform with said requirements.

(a) Corner location: Township 37 North

Range 8 East/West

Town/City/Village Newbold

County Oneida

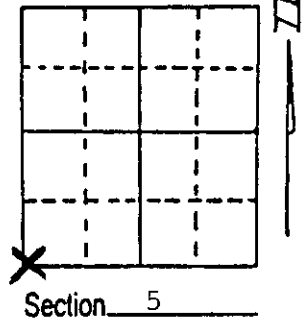

(b) (f) (g) (h) Description of monument found at this corner and if it was accepted, state all evidence (material, testimonial, occupational, plats, records, other monuments) used as a basis for accepting. If not accepted or if nothing was found, state evidence used as basis for establishing location. If reestablished through lost corner proportionate methods, indicate all monuments, distances and directions used to establish.

July 1863, Wm. E. Daugherty at 80.00 chains set post for section corner:

10" Tamarack, S61°E, 11 links (7.26')

10" Tamarack, N64°W, 12 links (7.92')

January 10, 1908, Vaughan found original post and BTs okay.

February 17, 1954, Wincentzen stated Vaughan tree to be a 5" Spruce (not a Tamarack) S72°E, 57 links (37.62').

Also, a 5" x 5" post.

February 4, 1988 Milo E. Stefan found post point 6" diameter rotted off with fragments of scribed top of post on ground with dead 6" Spruce S72°E, 37.5'.


Someone recently cut line from South and missed corner by 10' Easterly.

I accept this as the best remaining evidence of the corner.

(c) (d) (e) Plan view of corner with ties to at least 4 witness monuments. If in disagreement with previously established corner, show the distances between the two corners and also indicate the ties to the disputed corner.

1. 2" x 72" Oneida County aluminum monument 42" in ground.
2. 6" Cedar, N7°W, 81.77' (Scribed "X BT").
3. 7" Cedar, N60°E, 114.73' (Scribed "T37N R8E S5 BT")
4. 12" Cedar, S50°E, 127.14' (Scribed "T37N R8E S8 BT")
5. 6" Dead Spruce, S72°E, 37.5' (Vaughan or Wincentzen BT).
6. Plastic sign post next to monument.

Distances to nail in side of trees.

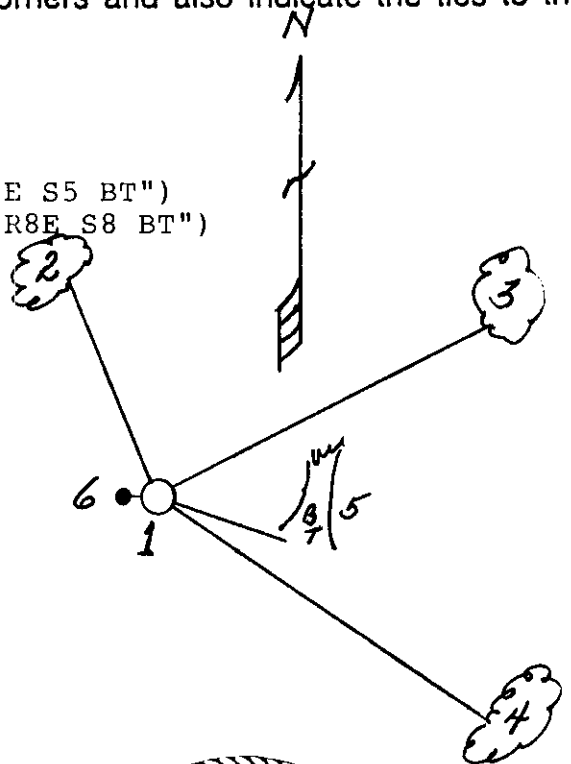

(i) I, Milo E. Stefan
 (type or print name) certify that the corner location on this record was determined by me or under my direction and control and that this U.S. Public Land Survey Monument Record is correct and complete to the best of my knowledge and belief.

Milo E. Stefan
 Signature

2/24/88
 Date



Index No. E-5

37C8060000