U.S. PUBLIC LAND SURVEY MONUMENT RECORD

Note: This form is intended and designed to fulfill all requirements of Wisconsin Administrative Code, Chapter A-E 5.02, U.S Public Land Survey Monument Record (3) (a) (b) (c) (d) (e) (f) (g) (h) (i). An additional sheet may be added if necessary to conform with said requirements.

(a) Corner location: Township 37 North

Range 8 East/~~West~~

Town/~~City/Village~~ Newbold

County Oneida

REGISTER OF DEEDS OFFICE ONEIDA COUNTY, WIS.
At 8:00 o'clock a M
DORIS VERNETTA KUCHN
REGISTER OF DEEDS

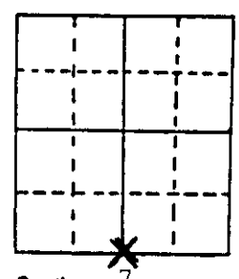

Section 7

(b) (f) (g) (h) Description of monument found at this corner and if it was accepted, state all evidence (material, testimonial, occupational, plats, records, other monuments) used as a basis for accepting. If not accepted or if nothing was found, state evidence used as basis for establishing location. If reestablished through lost corner proportionate methods, indicate all monuments, distances and directions used to establish.

July 1863, Wm. E. Daugherty in correcting east between sections 7 & 18, at 26.38 chains set post for 1/4 section corner:
1) 7" White Pine, N53 1/2?, 10 links (6.60')
2) 7" Maple, S33°W, 5 links (3.30')
November 8, 1890, B. F. Dorr found corner and set new BT:
1) 18" Pine stub, S16°E, 14 links (9.24')
November 10, 1953, Ivan Branham used this corner to sub-divide section 7 and set C 1/4 (from notes in county surveyor's office).
December 10, 1987 Milo E. Stefan found 4" x 4" x 36" burnt pine post with Dorr's pine stump S16°E.
I accempt this post as the best remaining evidence of the original corner position.

(c) (d) (e) Plan view of corner with ties to at least 4 witness monuments. If in disagreement with previously established corner, show the distances between the two corners and also indicate the ties to the disputed corner.

1. 2" x 30" Oneida County aluminum monument.
2. 12" Red Pine, N76°E, 19.27'.
3. 12" Red Pine, S30°E, 11.95'.
4. 16" Red Pine, S68°W, 36.08'.
5. 9" Red Oak, N23°W, 29.84'.
6. Plastic sign post, NW, 1.7'
   BT's scribed "1/4S BT".
   Distances measured to nail in side of trees.

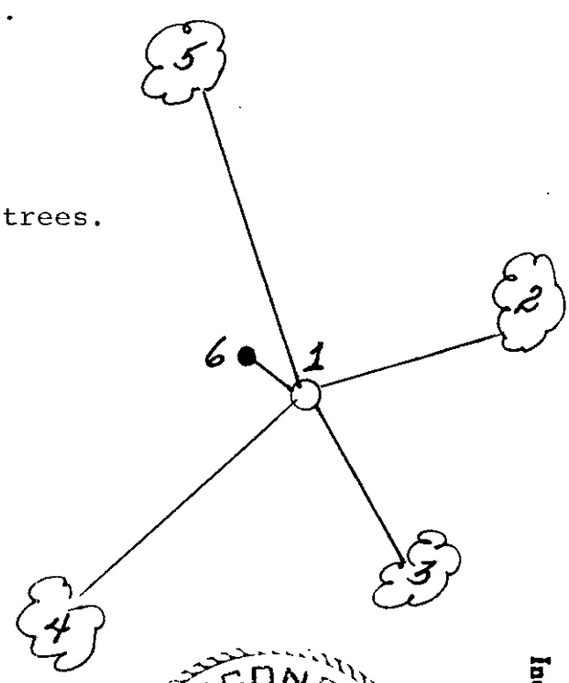

(i) I, Milo E. Stefan (type or print name) certify that the corner location on this record was determined by me or under my direction and control and that this U.S. Public Land Survey Monument Record is correct and complete to the best of my knowledge and belief.

Milo E Stefan — Signature

1/4/88 — Date

WISCONSIN MILO E. STEFAN S-1558 RHINELANDER, WIS. LAND SURVEYOR

Index No. 7-3

37-8-7-00-2-6