

U.S. PUBLIC LAND SURVEY MONUMENT RECORD



Note: This form is intended and designed to fulfill all requirements of Wisconsin Administrative Code, Chapter A-E 5.02, U.S. Public Land Survey Monument Record (3) (a) (b) (c) (d) (e) (f) (g) (h) (i). An additional sheet may be added if necessary to conform with said requirements.

(a) Corner location: Township 37 North

Range 8 East/West

Town/City/Village Newbold

County Oneida

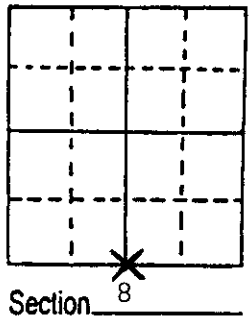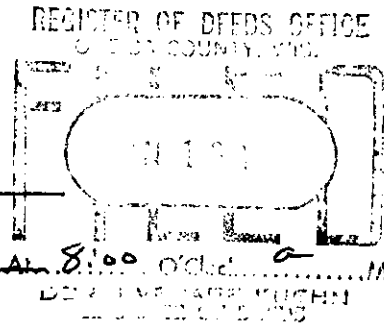

(b) (f) (g) (h) Description of monument found at this corner and if it was accepted, state all evidence (material, testimonial, occupational, plats, records, other monuments) used as a basis for accepting. If not accepted or if nothing was found, state evidence used as basis for establishing location. If reestablished through lost corner proportionate methods, indicate all monuments, distances and directions used to establish.


- July 1863, Wm. E. Daugherty at 39.90 chains set post for 1/4 corner:
 - 10" Aspen, S18°E, 11 links (7.26')
 - 10" Maple, N49°W, 18 links (11.88')
- August 23, 1949 F.R. Wincentzen found 5" x 5" post with Vaughn's NE Pine BT, N61°E, 59 links (38.94')
- December 3, 1987 Milo E. Stefan found 1" x 24" iron pipe with 3" x 3" x 4' Oak post in mound of stone. Vaughn's BT, a pine stump, face burnt out. I accept this iron pipe as the best remaining evidence of this corner.

(c) (d) (e) Plan view of corner with ties to at least 4 witness monuments. If in disagreement with previously established corner, show the distances between the two corners and also indicate the ties to the disputed corner.

1. 2" x 36" Oneida County aluminum monument in mound of stone.
- *2. 6" Red Maple, N66°E, 56.57'
- *3. 8" White Birch, S81°E, 45.06'
- **4. 2" Red Oak, S14°W, 39.36'
- *5. 6" White Birch, N15°W, 39.34'
6. Plastic sign post, SE, 1.4'

*BT's scribed "1/4S BT"
 **BT scribed "X BT"
 Distances measured to nail in side of tree.

7. 12" Red Pine stump, N61°E, 40.10'

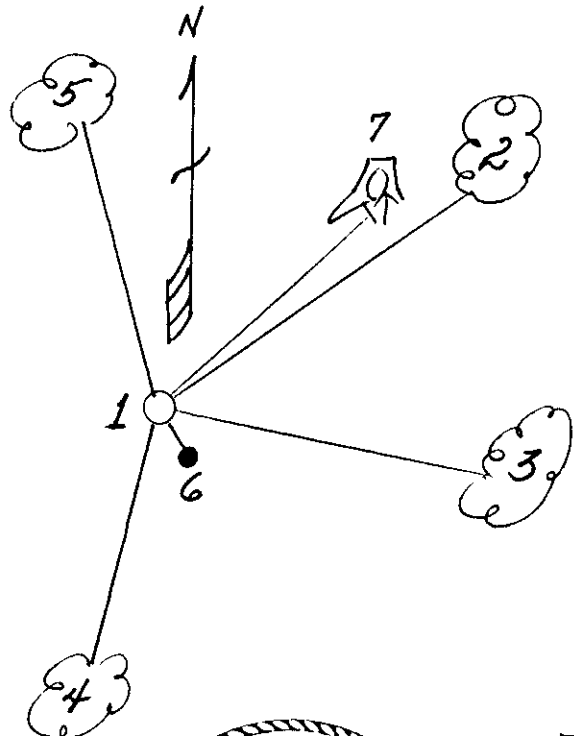

(i) I, Milo E. Stefan
 (type or print name) certify that the corner location on this record was determined by me or under my direction and control and that this U.S. Public Land Survey Monument Record is correct and complete to the best of my knowledge and belief.

Milo E. Stefan 1/4/88
 Signature Date



Index No. J-7

3708080020