U.S. PUBLIC LAND SURVEY MONUMENT RECORD

Note: This form is intended and designed to fulfill all requirements of Wisconsin Administrative Code, Chapter A-E 5.02, U.S. Public Land Survey Monument Record (3) (a) (b) (c) (d) (e) (f) (g) (h) (i). An additional sheet may be added if necessary to conform with said requirements.

(a) Corner location: Township 37 North

Range 8 East/~~West~~

Town/~~City/Village~~= PIne Lake

County Oneida

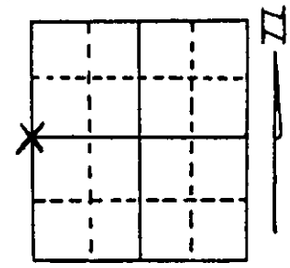

Section 10

(b) (f) (g) (h) Description of monument found at this corner and if it was accepted, state all evidence (material, testimonial, occupational, plats, records, other monuments) used as a basis for accepting. If not accepted or if nothing was found, state evidence used as basis for establishing location. If reestablished through lost corner proportionate methods, indicate all monuments, distances and directions used to establish.

July 1863 Wm. E. Daugherty set wood post for 1/4 corner:
8" Jack Pine, N40°E, 17 links (11.22')
10" Jack Pine, S34°W, 16 links (10.56')
February 19, 1988 Milo E. Stefan found squared up oak post. With two Jack Pine blazed and scribed in stump blaze. The growth on these two trees is 35-40 years ago. As consolidated Paper Company owns land southeast, it is expected they have perpetuated this corner.
I accept this oak post and scribed trees as the perpetuation of the original corner position and monument same.

(c) (d) (e) Plan view of corner with ties to at least 4 witness monuments. If in disagreement with previously established corner, show the distances between the two corners and also indicate the ties to the disputed corner.

1. 2" x 30" Oneida County aluminum monument
2. 6" Red Maple, N33°E, 20.80' (1/4S BT)
3. 12" Jack Pine, S18°E, 2.79' (1/4S)
4. 4" Scotch Pine, S67°W, 21.67' (X BT)
5. 12" Jack Pine, N39°W, 7.48' (1/4S)
6. Plastic sign post, west, 1.3'.

Measurements to nail in side of trees.
(Indicates scribing at this time)

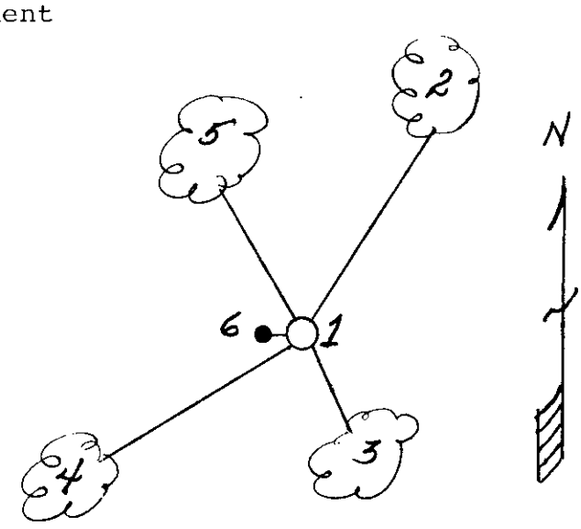

(i) I, Milo E. Stefan (type or print name) certify that the corner location on this record was determined by me or under my direction and control and that this U.S. Public Land Survey Monument Record is correct and complete to the best of my knowledge and belief.

Milo E Stefan 2/26/88

Signature Date

WISCONSIN MILO E. STEFAN S-1558 RHINELANDER, WIS. LAND SURVEYOR

Index No. G-13

37C8C91 2C00