

CERTIFIED LAND CORNER RESTORATION

Index No. 5-17

State of Wisconsin } ss.  
County of ONEIDA

I William Immich, do hereby certify that on the 19<sup>th</sup> day of April, 1981, I found evidence of the NORTHEAST corner of SECTION 15 Township 37, North, Range 8 EAST, Fourth Principal Meridian, as described hereon; and that from this evidence I established a new monument and accessories as described hereon to perpetuate the original location of this corner.


Resident witnesses.

MIKE ROMBERTL

MARK HENDRICKSON

COMPARED WITH RECORD DATA AND FOUND TO BE CORRECT & ACCEPTED.

Paul H. Rhind, Oneida County Surveyor  
10 June 1981

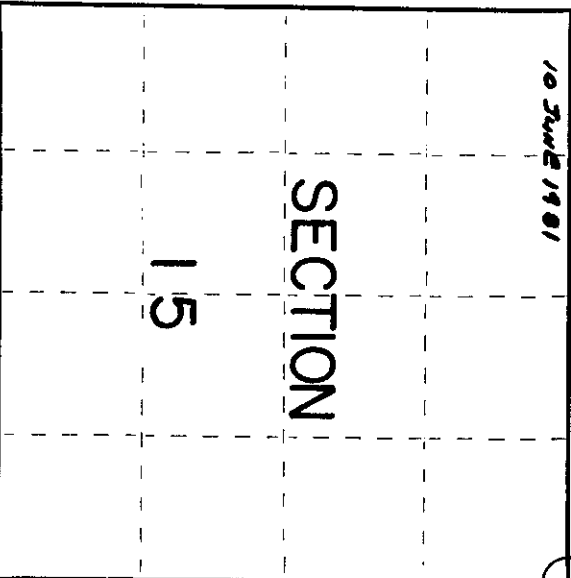

○ = Corner monument restored.

History of original corner establishment:

Set by William Daugherty July 1863

" North between 14 & 15 V 70° E, 80.00 Set post corner to Sec. 10, 11, 14, 15 WILLIAM G.

W. Pine 15 N 5 W 11

W. Pine 10 S 7 E 35

Description of corner evidence found:

Found P.K. nail in road, found reference pipe 33.00' north and south of corner.

Found bearing tree 6" birch N 34° W 41.5' leaning, cannot find record of tree.


Robert Badow - found reference pipe in place 1930

William Badow - found reference pipe in place - set P.K. nail 1977

F.R. Wincentsen - shows distance to corner on map dated Aug. 3, 1947 does not describe corner.

Description of monument and accessories I established to perpetuate the original location of this corner.

Set aluminum Oneida County monument 2" below road surface - stamped as shown.

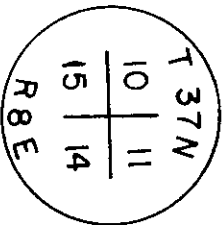

\*BEARING TREES\*

- 5" maple N 33° W 54.28'
- 4" maple N 65° E 73.80'
- 3" maple S 65° E 69.40'
- 3" maple S 38° W 43.46'

Dated at RHINELANDER, Wis., this 12<sup>th</sup> day of MAY, 1981.

Signature: William Immich Title: REGISTERED LAND SURVEYOR Registration No. 1383  
(County Surveyor, Registered Land Surveyor, or other duly authorized official)

Office of Register of Deeds, County of Oneida I hereby certify that the within instrument was filed in this office for record on the 21<sup>st</sup> day of December, 1981 at 9:12 o'clock A. M.

Donna George Fischer  
(Register of Deeds)

By: \_\_\_\_\_ Deputy

3708100000

