

CERTIFIED LAND CORNER RESTORATION

Index No. **5-15**

State of Wisconsin }
 County of ONEIDA } ss.

I William Tamlich, do hereby certify that on the 19 81 day of April, 19 81, I found evidence of the NORTH 1/4 corner of SECTION 15 Township 37, North, Range 8 EAST, Fourth Principal Meridian, as described hereon; and that from this evidence I established a new monument and accessories as described hereon to perpetuate the original location of this corner.

Resident witnesses:

MIKE ROMPORTL
MARK HENDRIKSSON

History of original corner establishment:

Set by William Daugherty July 1863
 * East random line between Sections 10 & 15 V 7° 25' E 79.92' intersected Section line 47 1k north of post West corrected V 7° 5' E 39.96 set 1/4 post
 Y. Pine 12 N 36 E 68
 birch 6 N 67 W 17

Description of corner evidence found:

Found 1" iron pipe in place, tall 2" iron pipe next to it also a squared wooden post.


F.R. Wincentzen - found iron pipe - August 1947 says it is Vaughn's cannot find record of Vaughn

Sy. M. Poskie - found iron pipe - tied plat into corner June 1962

Found no bearing trees


Description of monument and accessories I established to perpetuate the original location of this corner.

Set aluminum Oneida County Monument on top edge of cut of Journey End Road - pipe 4" above ground - stamped as shown.

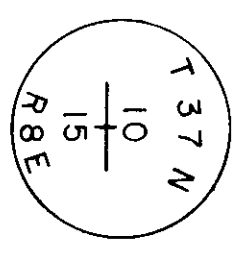

BEARING TREES

- 5" white pine S 14° W 10.58'
 - 6" white pine N 2° W 52.96'
 - 18" oak S 73° E 47.32'
 - 10" white pine N 63° W 73.33'
- center line of black top road North 13.5'

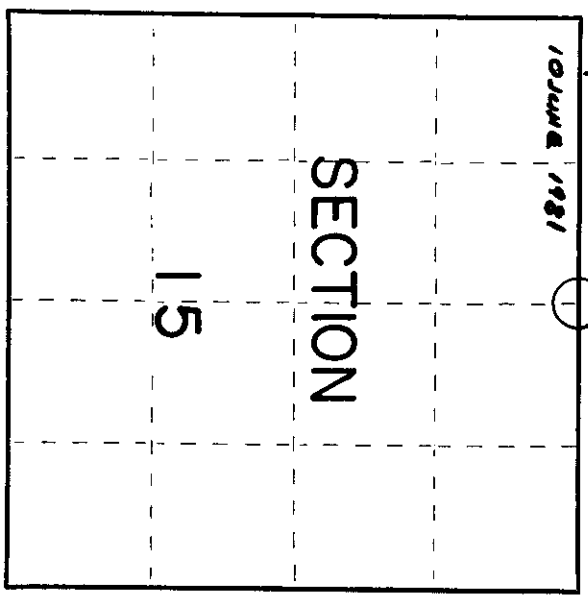

○ = Corner monument restored.


Dated at RHINELANDER, Wis. this 12th day of MAY, 19 81.

 (County Surveyor, Registered Land Surveyor, or other duly authorized official)

Office of Register of Deeds, County of Oneida I hereby certify that the within instrument was filed in this office for record on the 21st day of December, 19 81 at 4:10 o'clock a M.

Doris Lange Kuehn
 Register of Deeds

By: _____ Deputy

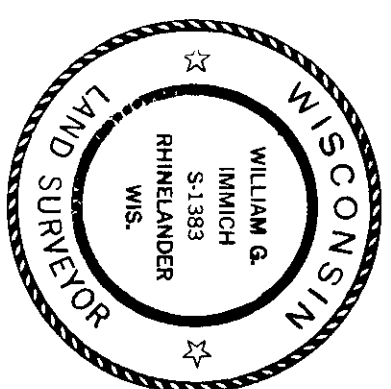


3708160020

U.S. PUBLIC LAND SURVEY MONUMENT RECORD

Note: This form is intended and designed to fulfill all requirements of Wisconsin Administrative Code, Chapter A-E 7.08 U.S. Public Land Survey Monument Record (3) (a) (b) (c) (d) (e) (f) (g) (h) (i). An additional sheet may be added if necessary to conform with said requirements.

(a) Corner location: Township 37 North
 Range 8 East/West

Town/City/Village PINE LAKE
 County ONEIDA

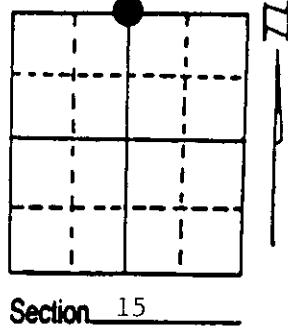


(b) (f) (g) (h) Description of monument found at this corner and if it was accepted, state all evidence (material, testimonial, occupational, plats, records, other monuments) used as a basis for accepting. If not accepted or if nothing was found, state evidence used as basis for establishing location. If reestablished through lost corner proportionate methods, indicate all monuments, distances and directions used to establish. Indicate type of monument found or set and sign post.

- 6/24/1993 - Milo E. Stefan found aluminum monument in South ditch line badly damaged. One BT recently cut down by power line clearing. We made one new BT and took ties to three others so if destroyed in road resurfacing, it could be restored.
- 5/10/1994 - We replaced damaged monument and covered it with mound of stone. Set plastic sign post.

(c) (d) (e) Plan view of corner with ties to at least 4 witness monuments. If in disagreement with previously established corner, show the distances between the two corners and also indicate the ties to the disputed corner.


- 1) 2" x 36" aluminum monument in mound of stone.
- 2) 18" Red Oak, S73°E, 48.02'.
- 3) 12" Red Oak, S30°W, 30.06'.
- 4) 10" White Pine, N63°W, 73.40'.
- 5) 6" White Pine, N2°W, 52.67'.
- 6) 5" White Pine Stump, S14°W, 10.96'.
- 7) Plastic sign post, South, .8'.

Distances to nail in side of BTs.
 Slight difference appears due to measuring point.
 Stump blazes scribed "BT".

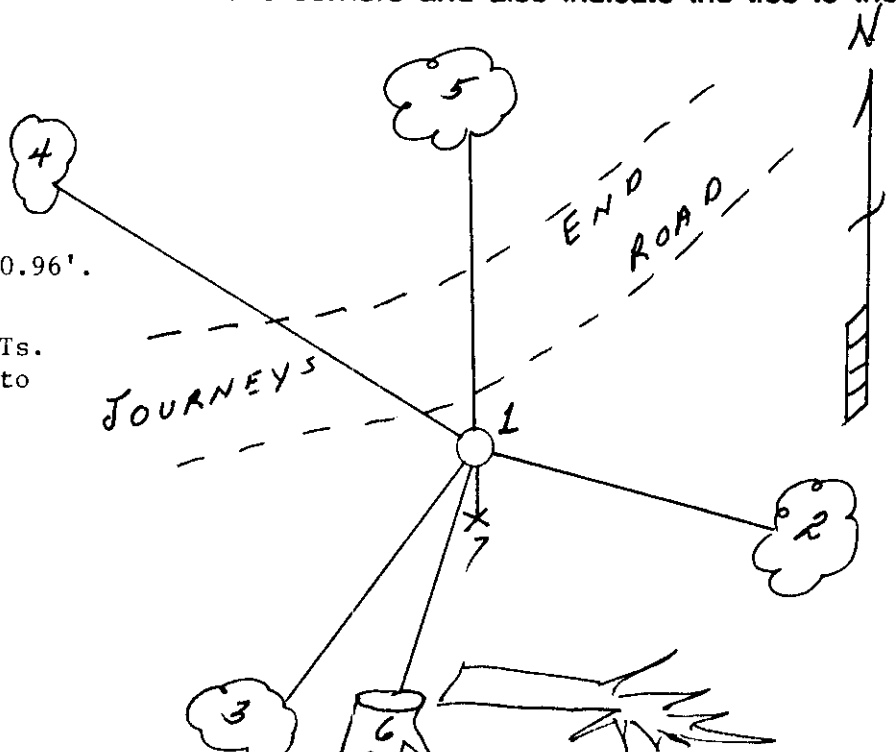

(i) I, Milo E. Stefan
 (type or print name) certify that the corner location on this record was determined by me or under my direction and control and that this U.S. Public Land Survey Monument Record is correct and complete to the best of my knowledge and belief.

Milo E. Stefan Signature
 May 19, 1994 Date

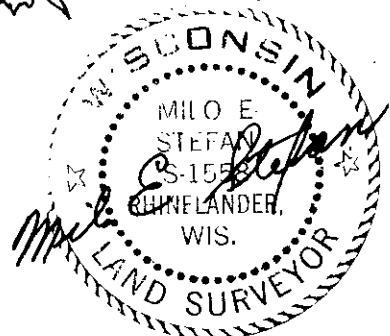

Stamp 3708100020

Index No. J-15