

CERTIFIED LAND CORNER RESTORATION

Index No. **H-21**



State of Wisconsin } ss.
 County of Oneida

I Phillip T. Hansen, do hereby
 certify that on the 6th day
 of May, 1977, I found

evidence of the S 1/16
 corner of Section 11 & 12
Township 37, North, Range
8 East, Fourth Principal Meridian,

as described hereon; and that from this evidence
 I established a new monument and accessories
 as described hereon to perpetuate the original
 location of this corner.

Resident witnesses:
Jim Claflin
Herb Wagoner

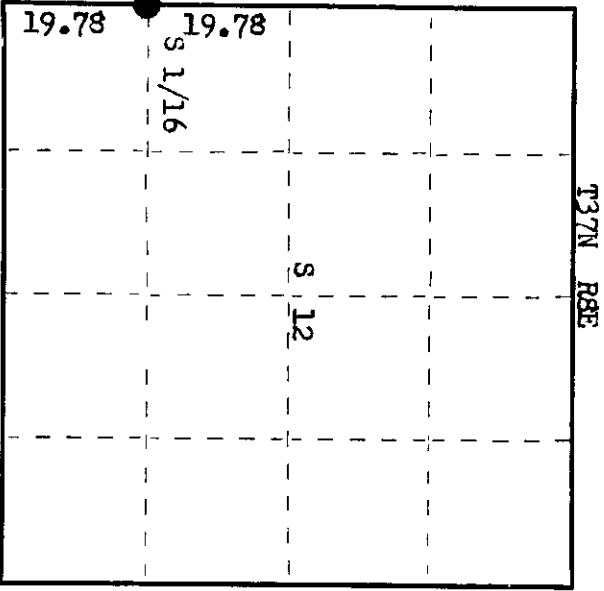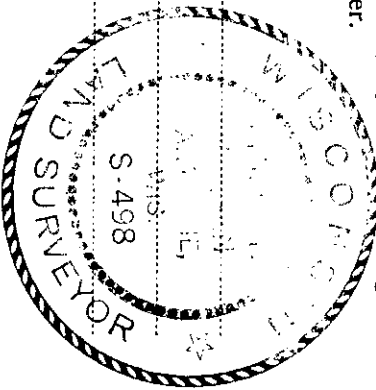

○ = Corner monument restored.

History of original corner establishment:

Corner established by N. Loftus, Ripco surveyor, in 1960. Ran random line south from Section Corner 1, 2, 11 & 12, 79.12 chains, checked Vaughan's chainage to old fence corner. Set 1/4 corner by Vaughn's old BFs and set S 1/16 corner at 19.78 chains intermediate between 1/4 corner and SW section corner.

Marked NBTs - White Pine 12" S20°E, 23 1/2 links
 Black Spruce 4" N72°E, 2 1/2 links.

Description of corner evidence found:

Recovered 1" iron pipe with 2" square brass cap in good condition, firmly in ground, projecting 18" above ground. Cap stamped:
 Recovered Black Spruce 4" (6") N72°E, 2.5 links, our bearing N82°E.
 White Pine 12" (14") S20°E, 23.5 links,
 scribed S 1/16 S12 BT.

T37N R8E
 S 1/16
 S11 S12
 RIPCO

Description of monument and accessories I established to perpetuate the original location of this corner.
As corner was recovered in good condition, it was left as recovered.
 No additional accessories established.

Dated at Rhinelander, Wis. this 10th day of May, 1977

Signature: Phillip T. Hansen Title: Registered Land Surveyor Registration No. S-498
 (County Surveyor, Registered Land Surveyor, or other duly authorized official)

Office of Register of Deeds, County of Oneida, I hereby certify that the within
 instrument was filed in this office for record on the 16th day of May, 1977
 at 10:30 o'clock A.M.

Devin Henage-Kuehn
 (Register of Deeds)

By: _____ Deputy

370811000