

CERTIFIED LAND CORNER RESTORATION

Index No. G-21

State of Wisconsin



County of Oneida } ss.

I Phillip T. Hansen, do hereby certify that on the 6th day of May, 1977, I found evidence of the Quarter corner of Section 10 & 11 Township 37, North, Range 8 East, Fourth Principal Meridian, as described hereon; and that from this evidence I established a new monument and accessories as described hereon to perpetuate the original location of this corner.

Resident witnesses:

Jim Charlton

Herb Wagoner

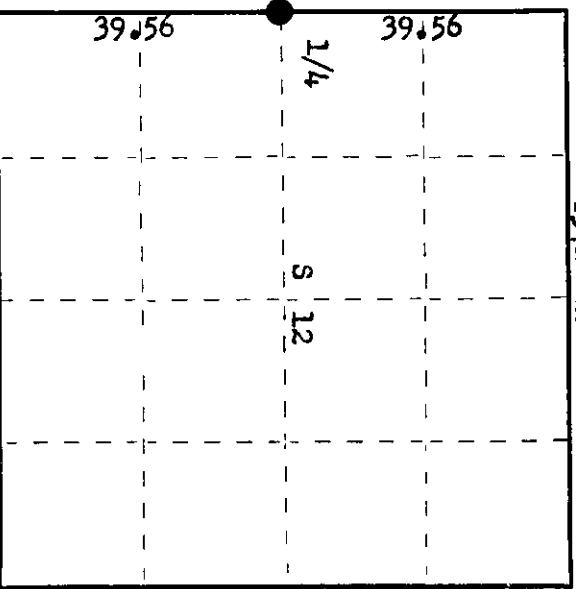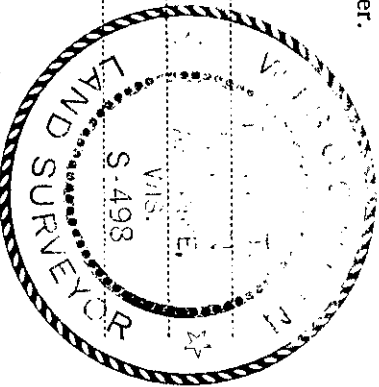

○ = Corner monument restored.

History of original corner establishment:

Corner established by Wm. E. Dougherty, Deputy Surveyor, in 1853. Corner recovered and re-marked by D.H. Vaughan, County Surveyor. N.J. Loftus, Ripco surveyor, recovered a corner here in 1960. Ran line south from Section Corner 1, 2, 11 & 12 at 39.56 chains, recovered Vaughan's Red Pine BT, then a stump, badly burned. Marked NBTs - Red Pine 12", N57°W, 17 links Spruce 4" S34°E, 22-3/4 links

Description of corner evidence found:

Recovered 2" iron pipe with 4" square brass cap, stamped: Monument projects 20" above ground, recovered in excellent condition and firmly in ground. Recovered Red Pine 12" (20") N57°W (N45°W) 17.0 (21.0), scribing not legible. Black Spruce 4" (6") S34°E (S48°E) 22.75 links (15.5 lks), scribed 1/4 S12. T37N R8E 1/4 S S11 S12 R1PCO

Description of monument and accessories I established to perpetuate the original location of this corner.

As monument was recovered in excellent condition, it was left in place. Marked NBT - Black Spruce 6" S34°W, 18.2 links, scribed 1/4 BT.

Dated at Rhineland Wis. this 10th day of MAY, 1977

Signature: Phillip T. Hansen Title: Registered Land Surveyor Registration No. S-498  
(County Surveyor, Registered Land Surveyor, or other duly authorized official)

Office of Register of Deeds, County of Oneida I hereby certify that the within instrument was filed in this office for record on the 16th day of May, 1977 at 10:30 o'clock A. M.

Lewis Wagoner Kuehn  
(Register of Deeds)

By: \_\_\_\_\_ Deputy

370812000