

CERTIFIED LAND CORNER RESTORATION



Index No. V-25

State of Wisconsin

County of Oneida } ss.

I Phillip T. Hansen, do hereby certify that on the 29th day of April, 1977, I found evidence of the Section corner of Sec. 12, 7, 13 & 18 Township 37 North, Range 8 & 9 East, Fourth Principal Meridian, as described hereon; and that from this evidence I established a new monument and accessories as described hereon to perpetuate the original location of this corner.

Resident witnesses:  
Jim Clafflin  
Herb Wagoner

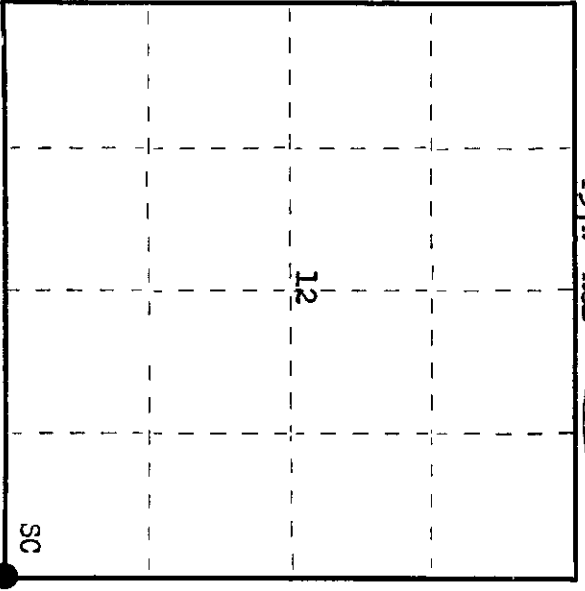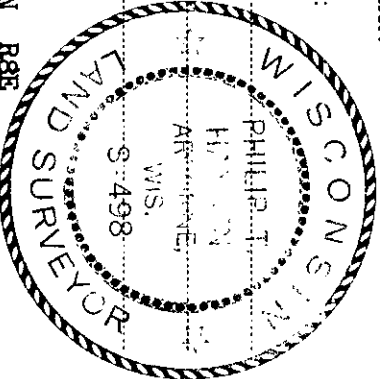

○ = Corner monument restored.

History of original corner establishment:

Original Corner established by H.C. Fellows, Deputy Surveyor, in 1860, from which Yellow Pine 16" bears S27°W, 32 links and White Pine 15" bears N73°W, 9 links, White Pine 20" bears N54°E, 52 links and Yellow Pine 20" bears S53°E, 18 links.

This corner recovered by Ripco surveyors in 1960. Ran line North from it, but no mention made of corner recovered or BTs in evidence.

Description of corner evidence found:

Recovered 2" iron pipe with 4" square brass cap in excellent condition and securely in ground.

Recovered OBTs - White Birch 7" N69°W, 19.3 links, scribing grown over. Maple, twin 7" S24°W, 8.5 links, scribing not legible.

Monument projects 15" above ground. Cap stamped:  
T37N S12 | S7 T37N  
R8E S13 | S18 R9E  
RIPCO

Description of monument and accessories I established to perpetuate the original location of this corner. As the monument was recovered in excellent condition, it was left in place.

Marked NBTs - White Spruce 6" S40°W, 35.8 links, scribed SC BT. White Spruce 8" N64°E, 47.2 links, scribed SC BT.

Dated at Rhineland, Wis., this 3rd day of May, 1977.

Signature Phillip T. Hansen, Title Registered Land Surveyor, Registration No. S-498  
(County Surveyor, Registered Land Surveyor, or other duly authorized official)

Office of Register of Deeds, County of Oneida, I hereby certify that the within instrument was filed in this office for record on the 5th day of May, 1977 at 2:02 o'clock P. M.

Doris A. Sprague Kuehn  
(Register of Deeds)

By \_\_\_\_\_ Deputy