

CERTIFIED LAND CORNER RESTORATION

Index No. H-24

State of Wisconsin }  
 County of Oneida } ss.

I Philip T. Hansen do hereby  
 certify that on the 29th day  
 of April 19 77, I found



evidence of the SE 1/16  
 corner of Section 12  
 Township 37, North, Range  
8 East, Fourth Principal Meridian,

as described hereon; and that from this evidence  
 I established a new monument and accessories  
 as described hereon to perpetuate the original  
 location of this corner.

Resident witnesses:

Jim Claflin

Herb Wagoner

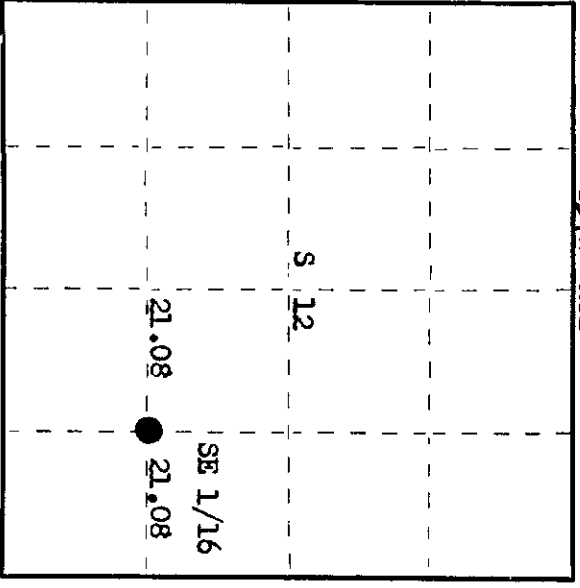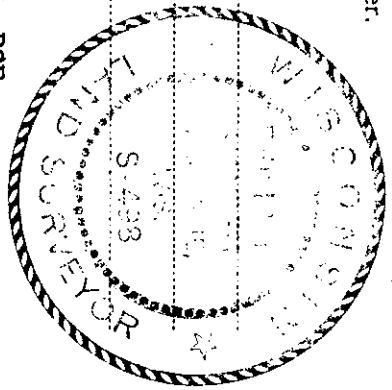

○ = Corner monument restored.

History of original corner establishment:

Corner established by N. Loftus, Ripco Surveyor, in 1960. From previously established  
 SC 1/16 ran a random line east 90° mag. 42.16 chains to close out 29 links north.  
 Corrected bearing N89° 45' E. Set SE 1/16 corner at 21.08 chains and marked NBTs -  
 Maple 9" S27°E, 8 links and Red Pine 13" N50°E, 7½ links.

Description of corner evidence found:

Recovered 3/4" iron pipe with 2" square brass cap in good condition and secure in ground.  
 Monument projects 22" above ground. Cap stamped:

Recovered OBTs - Maple 7" S28°E, 8.0 links (7.7 links), scribed SE 1/16 S12 BT.  
 Red Pine 13" (20") N50°E, 74.5 links, scribed SE 1/16 S12 BT.

T37N R8E  
 SE 1/16 S12  
 RIPCO

Description of monument and accessories I established to perpetuate the original location of this corner.  
 As monument was recovered in good condition and secure in ground, it was left as recovered.  
 No additional accessories were established.  
 Monument sets 1.5 chains east of Bertram Lake shoreline.

Dated at Rhinelander, Wis., this 4th day of May, 19 77.

Signature Philip T. Hansen Title Registered Land Surveyor Registration No. S-498  
 (County Surveyor, Registered Land Surveyor, or other duly authorized official)

Office of Register of Deeds, County of Oneida  
 Instrument was filed in this office for record on the 6th day of May, 19 77  
 at 1:00 o'clock P. M.

Doree Berge Kuehn  
 (Register of Deeds)

By \_\_\_\_\_ Deputy

370812 1010