

CERTIFIED LAND CORNER RESTORATION

Index No. A-22

State of Wisconsin

County of Oneida } ss.

I Phillip T. Hansen, do hereby

certify that on the 28th day

of March, 1980, I found

evidence of the SW 1/16

corner of Section 12

Township 37, North, Range


8 East, Fourth Principal Meridian,

as described hereon; and that from this evidence


I established a new monument and accessories

as described hereon to perpetuate the original

location of this corner.

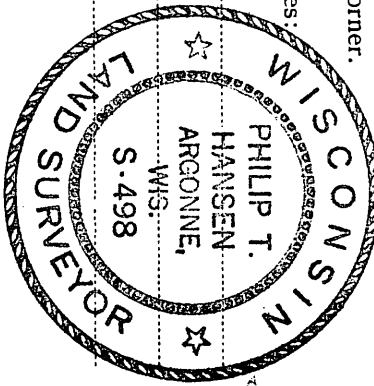

T37N R8E

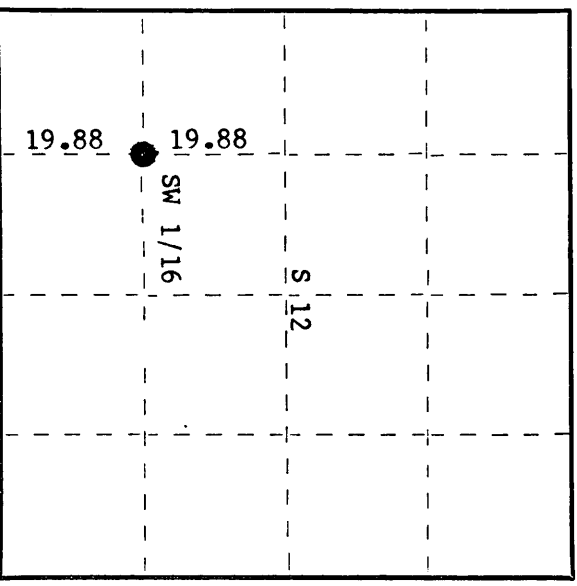

History of original corner establishment:

Corner established by N. Loftus, Ripco surveyor, in 1960. Ran random north from W 1/16 South line N 1°E 39.76 chains to close out 1.20 chains east of CW 1/16. Set SW 1/16 at 19.88 chains 60 links west.

Corrected bearing N 0° 44' W.  
Marked NBT's - Maple 4" N12°E 12-1/2 links  
Spruce 3" N90°W 67-3/4 links

Description of corner evidence found:

Recovered Ripco's 3/4" iron pipe with 2" square brass cap - stamped:

Recovered OBT's - Maple 4" (6") N12°E 12.5 links

B. Spruce 3" (6") N90°W 67.75 links

No additional accessories established.

T37N R8E  
S 12  
SW 1/16  
RIPCO

Description of monument and accessories I established to perpetuate the original location of this corner.

Dated at Rhinelander, Wis., this 7th day of April, 1980

Signature Phillip T. Hansen Title Registered Land Surveyor Registration No. S-498  
(County Surveyor, Registered Land Surveyor, or other duly authorized official)

Office of Register of Deeds, County of Oneida 16th day of May, 1980  
at 10 o'clock A. M. I hereby certify that the within

Signature Doris George Fuchs  
(Register of Deeds)

By Doris George Fuchs Deputy

○ = Corner monument restored.

3708121030