

CERTIFIED LAND CORNER RESTORATION

Index No. G-24

State of Wisconsin



County of Oneida } ss.

I Phillip T. Hansen, do hereby certify that on the 29th day of April, 1977, I found evidence of the EC 1/16 corner of Section 12 Township 37 North, Range 8 East, Fourth Principal Meridian, as described hereon; and that from this evidence I established a new monument and accessories as described hereon to perpetuate the original location of this corner.

Resident witnesses:

Jim Clafflin

Herb Wagoner

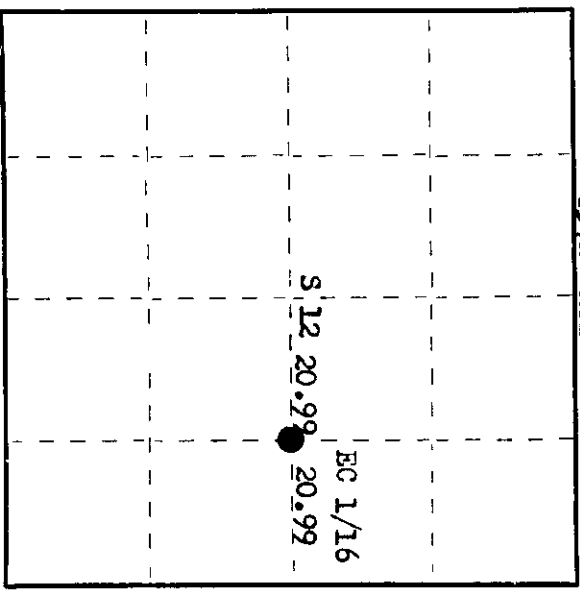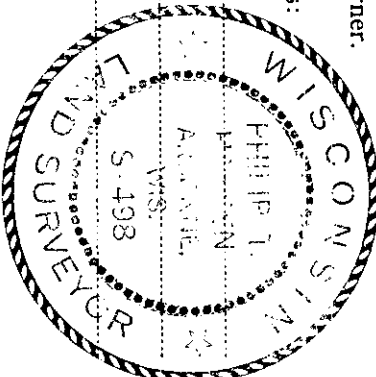

○ = Corner monument restored.

History of original corner establishment:

Corner established by N. Loftus, Ripco Surveyor, in 1960. Ran random line east from W 1/4 corner 83.96 chains to close out 1.21 chains north of E 1/4 corner. Ran N-S 1/4 line to establish the C 1/4 corner at 41.97 chains east. Set EC 1/16 corner at 62.965 chains equidistant between C 1/4 corner and E 1/4.

Marked NBTs - Oak 7" N52°E, 14 links.
Oak 5" N 18°W, 43-3/4 links.

Description of corner evidence found:

Recovered 3/4" iron pipe with 2" square brass cap, stamped:
Monument projects 18" above ground.
Recovered OBTs - Oak 7" (8") N52°E, 14.0 links, scribing not legible.
Oak 5" (6") N18°W, 43.2 links, scribing not legible.



Description of monument and accessories I established to perpetuate the original location of this corner. As monument was recovered in good condition and securely in ground, it was left as recovered. No additional accessories were established.

Dated at Rhinelander, Wis., this 4th day of May, 1977.

Signature Phillip T. Hansen, Title Registered Land Surveyor, Registration No. S-498
(County Surveyor, Registered Land Surveyor, or other duly authorized official)

Office of Register of Deeds, County of Oneida, I hereby certify that the within instrument was filed in this office for record on the 5th day of May, 1977, at 2:00 o'clock P. M.

Doris M. Hage
(Register of Deeds)

By Doris M. Hage Deputy

0102218073