

CERTIFIED LAND CORNER RESTORATION

Index No. **G-23**

State of Wisconsin



County of Oneida } ss.

I Phillip T. Hansen, do hereby certify that on the 1st day of April, 19 77, I found evidence of the C 1/4 corner of Section 12 Township 37 North, Range 8 East, Fourth Principal Meridian, as described hereon; and that from this evidence I established a new monument and accessories as described hereon to perpetuate the original location of this corner.

Resident witnesses:

Jim Clarlin

Herb Wagoner

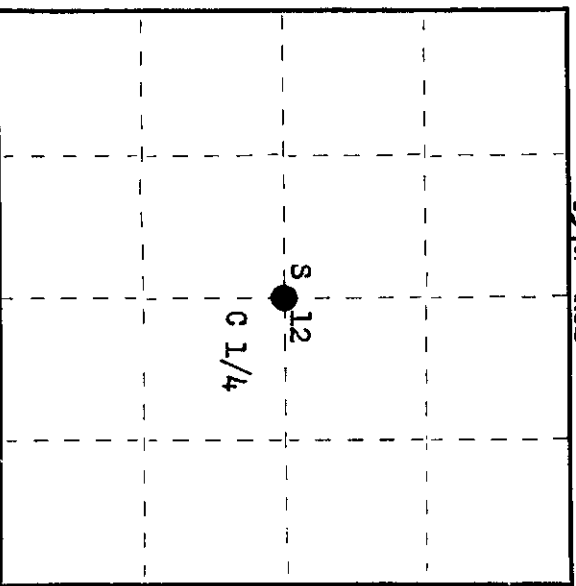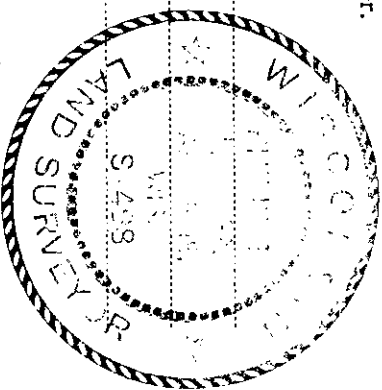

○ = Corner monument restored.

History of original corner establishment:

Corner established by N. Loftus, Ripco Surveyor, in 1960. From previously established S₄ corner ran a random line 358° 02' mag. 80.08 chains to close out 2.38 chains west of N₄ corner. Corrected bearing N 1° 15' W. Ran a random line East, bearing 89° 43' mag. 83.96 chains to close out 1.21 chains north of E₄ corner. Established C₄ corner at 41.97 chains and marked NBTs - Black Spruce 5" S40°W, 9 links, and Black Spruce 6" N58°E, 3 links.

Description of corner evidence found:

Recovered 2" iron pipe with 4" square brass cap projecting 20" above ground. Monument recovered in good condition and secure in ground.
Recovered OBTs - Black Spruce 5" (6") S40°W (S53°W) 9.0 links, scribed C₄ S12 T37N R8E
Black Spruce 6" N58°E (N46°E) 3.0 links, scribed C₄ S12 37-8 BT.
Cap stamped:

T37N R8E
C 1/4 S 12
RIPCO 1960

Description of monument and accessories I established to perpetuate the original location of this corner. As monument was recovered in good condition, it was left as recovered.
NBT - Black Spruce 6" S60°E, 16.6 links, scribed C 1/4 BT.

Dated at Rhineland Wis. this 4th day of May, 1977.

Signature Phillip T. Hansen Title Registered Land Surveyor Registration No. S-498
(County Surveyor, Registered Land Surveyor, or other duly authorized official)

Office of Register of Deeds, County of Oneida I hereby certify that the within instrument was filed in this office for record on the 6th day of May, 1977 at 1:28 o'clock P. M.

Doree Wenger Kuehn
(Register of Deeds)

By: _____ Deputy

370812 2020