U.S. PUBLIC LAND SURVEY MONUMENT RECORD

Note: This form is intended and designed to fulfill all requirements of Wisconsin Administrative Code, Chapter A-E 7.08 U.S. Public Land Survey Monument Record (3) (a) (b) (c) (d) (e) (f) (g) (h) (i). An additional sheet may be added if necessary to conform with said requirements.

(a) Corner location: Township 37 North

Range 9 East/~~West~~

Town/~~City~~/Village PINE LAKE

County ONEIDA

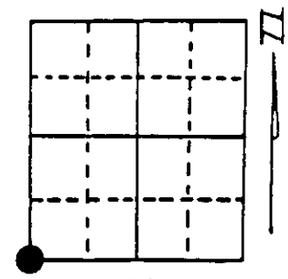

Section 18

(b) (f) (g) (h) Description of monument found at this corner and if it was accepted, state all evidence (material, testimonial, occupational, plats, records, other monuments) used as a basis for accepting. If not accepted or if nothing was found, state evidence used as basis for establishing location. If reestablished through lost corner proportionate methods, indicate all monuments, distances and directions used to establish. Indicate type of monument found or set and sign post.

6/28/1915 - Vaughan found stumps of original BTs and set 1 1/4" x 24" pipe for corner and 1 1/4" x 30" iron pipes for Witness East and West 37 1/2 Links.

6/24/93 - Milo Stefan found 1 1/4" x 30" iron pipe lying in East ditch. A fence line runs Westerly from corner area. A painted blue timber line runs Easterly.

4/19/1994 - We measured distance North and South and accepted the Center Line of road and fence line and paint line as reasonable position for this corner and monumented same.

(c) (d) (e) Plan view of corner with ties to at least 4 witness monuments. If in disagreement with previously established corner, show the distances between the two corners and also indicate the ties to the disputed corner.

1) Railroad spike.
2) 1 1/4" x 18" iron pipe, East, 33.0'.
3) 2" x 36" aluminum monument, East, 58.49'.
4) 16" Red Oak, N44°E, 118.78'.
5) 8" Red Oak, S81°E, 41.43'.
6) 12" White Pine, S85°W, 44.31'.
7) 18" Red Oak, N44°W, 92.86'.
8) Plastic sign post, East, 34.0'.

Distances to nail in side of BTs.
Stump blazes scribed "BT".

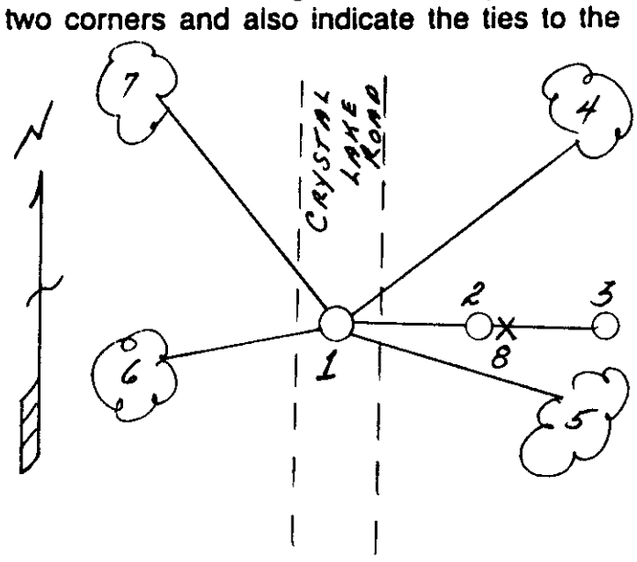

(i) I, Milo E. Stefan (type or print name) certify that the corner location on this record was determined by me or under my direction and control and that this U.S. Public Land Survey Monument Record is correct and complete to the best of my knowledge and belief.

Milo E. Stefan — 5/19/94

Signature — Date

WISCONSIN MILO E. STEFAN S-1858 RHINELANDER, WIS. LAND SURVEYOR

Index No. N-1

Stamp 37081300000