U.S. PUBLIC LAND SURVEY MONUMENT RECORD

Note: This form is intended and designed to fulfill all requirements of Wisconsin Administrative Code, Chapter A-E 7.08 U.S. Public Land Survey Monument Record (3) (a) (b) (c) (d) (e) (f) (g) (h) (i). An additional sheet may be added if necessary to conform with said requirements.

(a) Corner location: Township 37 North

Range 8 East/West

Town/City/Village PINE LAKE

County ONEIDA

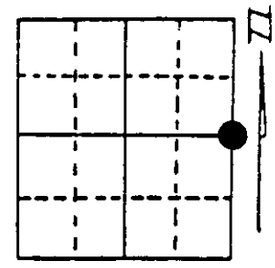

Section 13

(b) (f) (g) (h) Description of monument found at this corner and if it was accepted, state all evidence (material, testimonial, occupational, plats, records, other monuments) used as a basis for accepting. If not accepted or if nothing was found, state evidence used as basis for establishing location. If reestablished through lost corner proportionate methods, indicate all monuments, distances and directions used to establish. Indicate type of monument found or set and sign post.

1860 - H.C. Fellows set wood post for this corner/BTs:
8" Birch, S8°E, 14 Links (9.24') 12" Aspen, N33°W, 10 Links (6.6')

6/28/1915 - Vaughan found stumps of both original BTs and set a 1 1/2" x 24" iron pipe for corner with reference pipes East 37 1/2 Links and West 37 1/2 Links.

6/24/1993 - Milo Stefan searched and could find no trace of corner and gave permission to resurface road.

4/20/1994 - To confirm corner to South we ran traverse from P-25 to J-25 and searched area again. We found both of Vaughan's reference pipes and restored corner as indicated below.

(c) (d) (e) Plan view of corner with ties to at least 4 witness monuments. If in disagreement with previously established corner, show the distances between the two corners and also indicate the ties to the disputed corner.

1) Set railroad spike.
2) 1 1/2" x 30" iron pipe, S85°E, 25.21' (Vaughans).
3) 1 1/2" x 30" iron pipe, N85°W, 25.21' (Vaughans).
4) 6' x 4' x 3' high granite boulder/"X" on top (South end), N89°E, 65.59'.
5) 8" Red Oak, S62°E, 49.56'.
6) 12" White Pine, S43°W, 45.86'.
7) 10" Red Oak, N52°W, 78.86'.
8) Plastic sign post, S85°E, 25.3'.

Distances to nail in side of BTs.
Stump blazes scribed "BT".

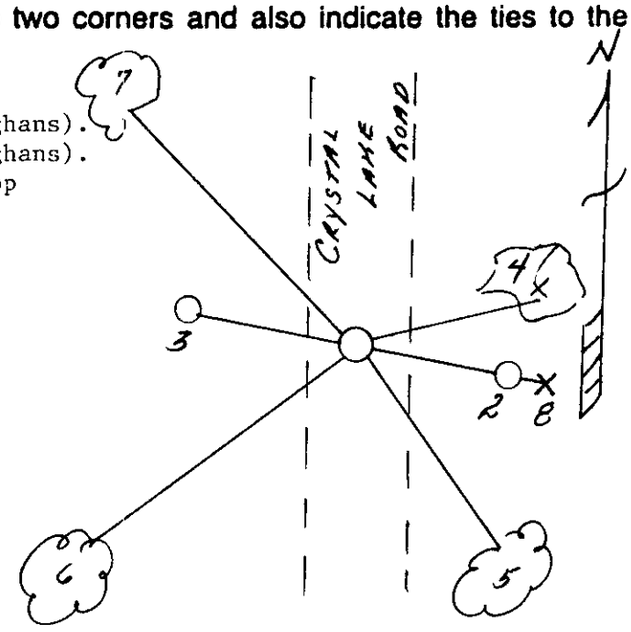

(i) I, Milo E. Stefan (type or print name) certify that the corner location on this record was determined by me or under my direction and control and that this U.S. Public Land Survey Monument Record is correct and complete to the best of my knowledge and belief.

Milo E. Stefan 5/19/94

Signature Date

WISCONSIN MILO E. STEFAN S-1558 RHINELANDER, WIS. LAND SURVEYOR

Index No. L-25

Stamp 37 08 13 2000