U.S. PUBLIC LAND SURVEY MONUMENT RECORD

Note: This form is intended and designed to fulfill all requirements of Wisconsin Administrative Code, Chapter A-E 7.08 U.S. Public Land Survey Monument Record (3) (a) (b) (c) (d) (e) (f) (g) (h) (i). An additional sheet may be added if necessary to conform with said requirements.

(a) Corner location: Township 37 North

Range 8 East/West

Town/City/Village PINE LAKE

County ONEIDA

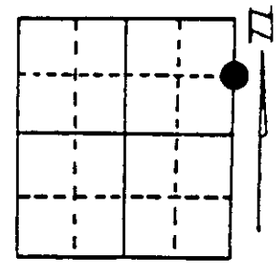

Section 13

(b) (f) (g) (h) Description of monument found at this corner and if it was accepted, state all evidence (material, testimonial, occupational, plats, records, other monuments) used as a basis for accepting. If not accepted or if nothing was found, state evidence used as basis for establishing location. If reestablished through lost corner proportionate methods, indicate all monuments, distances and directions used to establish. Indicate type of monument found or set and sign post.

4/19/1994 - Milo Stefan found 1 1/4" x 24" high iron pipe/2" x 2" x 1/4" brass plate as set by RIPCO surveyors 20 - 25 years ago. Only located one BT. We made a new BT and set plastic sign post as indicated below.

(c) (d) (e) Plan view of corner with ties to at least 4 witness monuments. If in disagreement with previously established corner, show the distances between the two corners and also indicate the ties to the disputed corner.

1) 1 1/4" x 24" iron pipe/B.C.
2) 12" Red Oak, S50°E, 8.35' (RIPCO).
3) 8" Red Maple, S55°W, 30.32'.
4) Plastic sign post, West, .6'.

Distances are to nail in side of BTs.
Stump blaze scribed "BT".

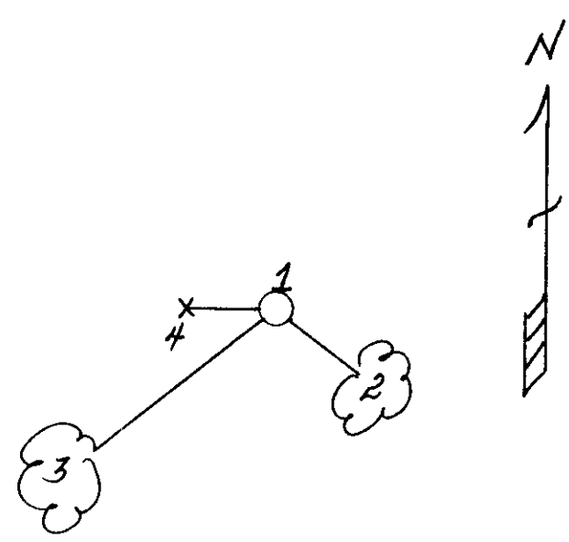

(i) I, Milo E. Stefan (type or print name) certify that the corner location on this record was determined by me or under my direction and control and that this U.S. Public Land Survey Monument Record is correct and complete to the best of my knowledge and belief.

Milo E. Stefan — Signature

5/19/94 — Date

WISCONSIN MILO E. STEFAN S-1558 RHINELANDER, WIS. LAND SURVEYOR

Index No. K-25

Stamp 3708/3300