


U.S. PUBLIC LAND SURVEY MONUMENT RECORD

Note: This form is intended and designed to fulfill all requirements of Wisconsin Administrative Code, Chapter A-E 7.08 U.S. Public Land Survey Monument Record (3) (a) (b) (c) (d) (e) (f) (g) (h) (i). An additional sheet may be added if necessary to conform with said requirements.

(a) Corner location: Township 37 North
 Range 8 East/West

Town/City/Village Newbold

County Oneida

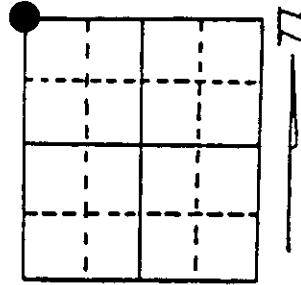

Section 22

(b) (f) (g) (h) Description of monument found at this corner and if it was accepted, state all evidence (material, testimonial, occupational, plats, records, other monuments) used as a basis for accepting. If not accepted or if nothing was found, state evidence used as basis for establishing location. If reestablished through lost corner proportionate methods, indicate all monuments, distances and directions used to establish. Indicate type of monument found or set and sign post.

July 1863 - Wm. Daugherty established this corner at 80.00 chains and set wood post with two BTs:

- 15" Red Pine, S32°E, 28 Links (18.48').
- 20" Red Pine, N50°W, 25 Links (16.50').

4/20/1902 - D.H. Vaughan found stumps of both original BTs. Did not restore this corner but restored the Quarter Corners south and east. Distances to these corners fit well today.

<u>N-13 to N-15</u>	
Vaughan 1902	2719.53 (±5.86')
Stefan 1992	2724.82

<u>N-13 to P-13</u>	
Vaughan 1902	2725.80 (±2.93')
Stefan 1992	2722.87

9/28/1954 - Wincentzen set iron pipe for corner in road and a W.C. pipe south 28.0'.

(c) (d) (e) Plan view of corner with ties to at least 4 witness monuments. If in disagreement with previously established corner, show the distances between the two corners and also indicate the ties to the disputed corner.


5/7/1959 - From state highway plat, new road center line is 143' northerly.

3/1978 - Winat used iron pipe for Section Corner in survey on map #A304 on file in county surveyor's office.

5/1992 - Milo E. Stefan found iron pipe and tied traverse south and east in Section 22 subdivision. We replaced the iron pipe with an aluminum monument, made new bearing trees and set plastic sign post.

- 1) 2" x 30" aluminum monument.
- 2) 5" Red Pine, North, 45.21'.
- 3) 8" Red Oak, S49°E, 90.85'.
- 4) 10" Red Pine, S61°W, 101.20'.
- 5) 18" Red Pine, N70°W, 146.40'.
- 6) Plastic sign post, East, 1.0'.

Distances to nail in side of BT.
 Stump blaze scribed "BT".

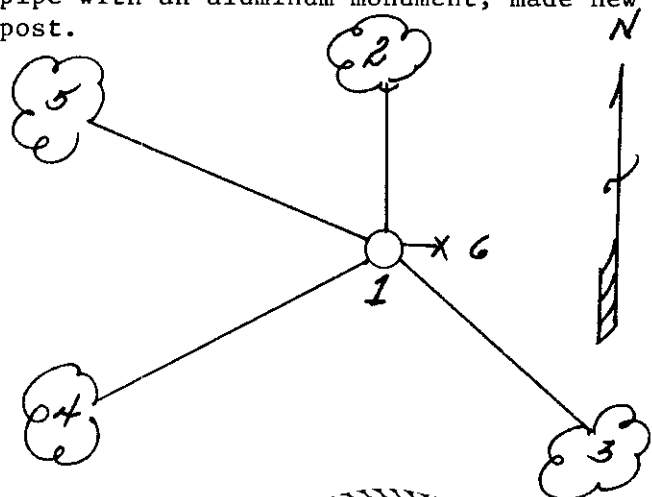

(i) I, Milo E. Stefan
 (type or print name) certify that the corner location on this record was determined by me or under my direction and control and that this U.S. Public Land Survey Monument Record is correct and complete to the best of my knowledge and belief.

Milo E. Stefan
 Signature

August 4, 1992
 Date



Index No. N-13

Stamp
 3708160000