U.S. PUBLIC LAND SURVEY MONUMENT RECORD

Note: This form is intended and designed to fulfill all requirements of Wisconsin Administrative Code, Chapter A-E 7.08 U.S. Public Land Survey Monument Record (3) (a) (b) (c) (d) (e) (f) (g) (h) (i). An additional sheet may be added if necessary to conform with said requirements.

(a) Corner location: Township 37 North

Range 8 East/~~West~~

Town/~~City/Village~~ Newbold

County Oneida

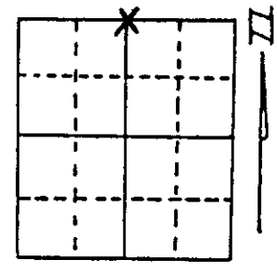

Section 21

(b) (f) (g) (h) Description of monument found at this corner and if it was accepted, state all evidence (material, testimonial, occupational, plats, records, other monuments) used as a basis for accepting. If not accepted or if nothing was found, state evidence used as basis for establishing location. If reestablished through lost corner proportionate methods, indicate all monuments, distances and directions used to establish.

July 1863, Wm. E. Daugherty set post for 1/4 corner to sections 16 and 21:
20" Red Pine, S13°E, 113 Links (74.58')
16" Red Pine, N52°W, 84 Links (55.44')
September 28, 1954 F. R. Wincentsen found iron pipe in road:
Telephone pole #152, N1°36'E, 27.3'
8" Jack Pine, S12°-19'E, 34.45'
May 17, 1988 Milo E. Stefan found Oneida county embossed monument in blacktop road with two BTs and two 1" iron pipes north and south of roadway.

(c) (d) (e) Plan view of corner with ties to at least 4 witness monuments. If in disagreement with previously established corner, show the distances between the two corners and also indicate the ties to the disputed corner.

1. Embossed Oneida County monument as set by other.
2. 6" Jack Pine, N12°E, 28.00 Feet (1/4S BT)
3. 6" Jack Pine, S62°E, 43.66 Feet
4. Power pole #3708-21W11, S51°W, 66.45 Feet
5. 14" Jack Pine, N42°W, 59.07 Feet
6. 1" iron pipe, north, 29.9 Feet
7. 1" iron pipe, south, 30.2 Feet
8. Plastic sign post, North 30.0 Feet
Distances to nail in side of trees.

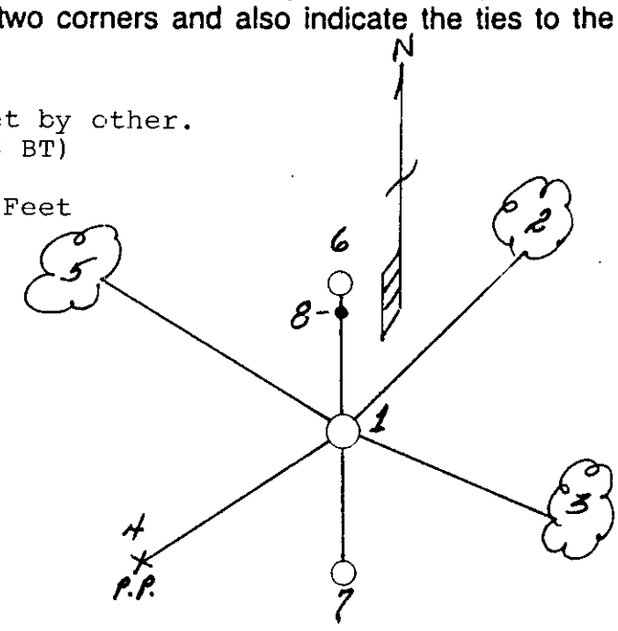

(i) I, Milo E. Stefan (type or print name) certify that the corner location on this record was determined by me or under my direction and control and that this U.S. Public Land Survey Monument Record is correct and complete to the best of my knowledge and belief.

Milo E Stefan — May 17, 1988

Signature — Date

WISCONSIN MILO E. STEFAN S-1558 RHINELANDER, WIS. LAND SURVEYOR

Index No. N-11

3708160020