

U.S. PUBLIC LAND SURVEY MONUMENT RECORD


Note: This form is intended and designed to fulfill all requirements of Wisconsin Administrative Code, Chapter A-E 5.02, U.S. Public Land Survey Monument Record (3) (a) (b) (c) (d) (e) (f) (g) (h) (i). An additional sheet may be added if necessary to conform with said requirements.

(a) Corner location: Township 37 North

Range 8 East/West

Town/City/Village Newbold

County Oneida

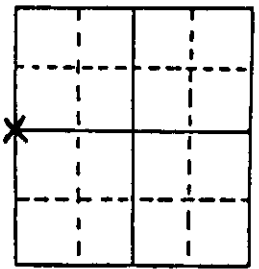

Section 15

(b) (f) (g) (h) Description of monument found at this corner and if it was accepted, state all evidence (material, testimonial, occupational, plats, records, other monuments) used as a basis for accepting. If not accepted or if nothing was found, state evidence used as basis for establishing location. If reestablished through lost corner proportionate methods, indicate all monuments, distances and directions used to establish.

July 1863, Wm. E. Daugherty at 40.00 chains set 1/4 section post:
 10" White Pine, S25°E, 8 links (5.28')
 8" Tamarack, N26°W, 19 links (12.54')


F.R. Wincentzen used this corner to establish S 1/16 to sections 15/16.
 12/76 Bill Bandow used this corner for county survey map #615.
 February 3, 1988 Milo E. Stefan found position marked by a 1" x 48" iron pipe and very decayed post point deep in swamp. I accept this position as the common used 1/4 corner and placed Oneida County monument over iron pipe.

(c) (d) (e) Plan view of corner with ties to at least 4 witness monuments. If in disagreement with previously established corner, show the distances between the two corners and also indicate the ties to the disputed corner.

1. 2" x 30" Oneida County aluminum monument over 1" x 48" iron pipe.
2. 10" Tamarack, N36°E, 37.08' **
3. 8" Tamarack, S24°E, 53.24' **
4. 3" Tamarack, S18°W, 28.89' *
5. 3" Tamarack, N41°W, 15.89' *
6. Plastic sign post

**Trees scribed "1/4S BT"
 *Trees scribed "X BT"


Distances measured to nail in side of trees.

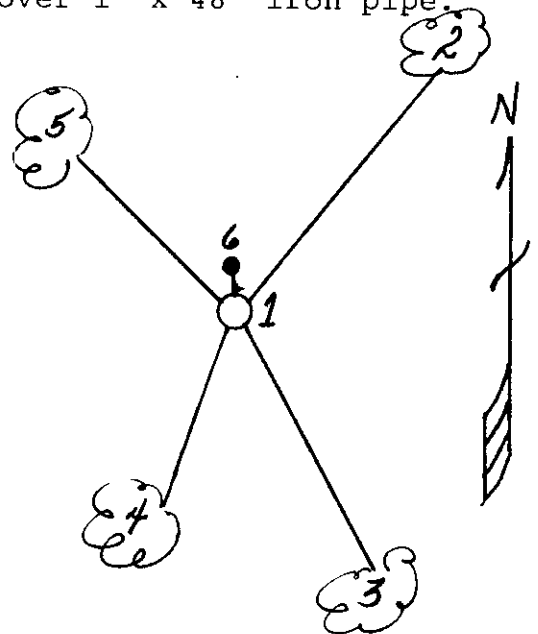

(i) I, Milo E. Stefan
 (type or print name) certify that the corner location on this record was determined by me or under my direction and control and that this U.S. Public Land Survey Monument Record is correct and complete to the best of my knowledge and belief.

Milo E. Stefan
 Signature

2/24/88
 Date

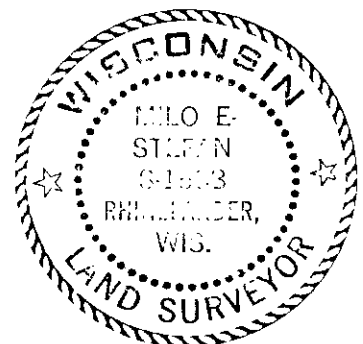

Index No. 2-13

370816-2000