U.S. PUBLIC LAND SURVEY MONUMENT RECORD

Note: This form is intended and designed to fulfill all requirements of Wisconsin Administrative Code, Chapter A-E 5.02, U.S Public Land Survey Monument Record (3) (a) (b) (c) (d) (e) (f) (g) (h) (i). An additional sheet may be added if necessary t conform with said requirements.

(a) Corner location: Township 37 North

Range 8 East/~~West~~

Town/~~City/Village~~= Newbold

County Oneida

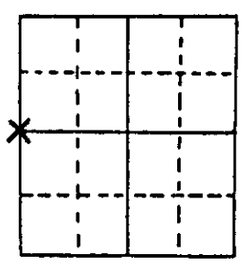

Section 16

(b) (f) (g) (h) Description of monument found at this corner and if it was accepted, state all evidence (material, testimonial, occupational, plats, records, other monuments) used as a basis for accepting. I not accepted or if nothing was found, state evidence used as basis for establishing location. I reestablished through lost corner proportionate methods, indicate all monuments, distances and directions used to establish.

July 1863; Wm. E. Daugherty at 40.00 chains set post for 1/4 corner:
6" Spruce, S61°E, 14 links (9.24').
8" Spruce, N86°W, 12 links (7.92').
September 28, 1954; F. R. Wincentsen had squared post and iron pipe
December 2, 1987; Milo E. Stefan found 1 1/4" x 42" iron pipe 30" in swamp with 1 1/4" x 36" well point and 3" x 3" x 5' Tamrack post (scribed 1/4S, 16, 17) along side:
5" Tamarack, N4°E, 20.23'.
6" Tamarack, S46°E, 8.96'.
5" Black Spruce, 56°W, 21.04'
scribed BT, 8 - 12 years ago.
I accept this position as the best remaining evidence of original corner.

(c) (d) (e) Plan view of corner with ties to at least 4 witness monuments. If in disagreement with previously established corner, show the distances between the two corners and also indicate the ties to the disputed corner.

1. 2" x 30" Oneida aluminum monument with both iron pipes wired to it to give it stability. Post driven along side.
2. 5" Tamarack, N4°E, 20.23'.
3. 6" Tamarack, S46°E, 8.96'.
4. 5" Black Spruce, S6°W, 21.04'.
5. 4" Black Spruce, N40°W, 12.37' scribed "1/4 S BT".
6. Plastic sign post, West, .7'.

Distances measured to nail in side of trees.

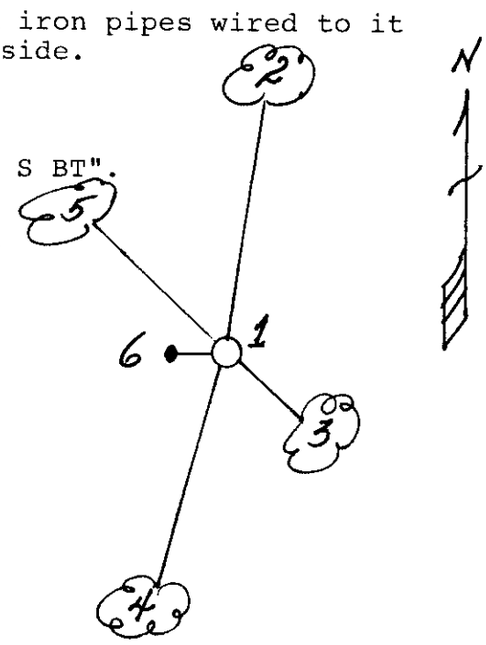

(i) I, Milo E. Stefan (type or print name) certify that the corner location on this record was determined by me or under my direction and control and that this U.S. Public Land Survey Monument Record is correct and complete to the best of my knowledge and belief.

Milo E. Stefan 12/6/87

Signature Date

WISCONSIN MILO E. STEFAN S-1558 RHINELANDER, WIS. LAND SURVEYOR

Index No. 7-9

3+08172 000