

CERTIFIED LAND CORNER RESTORATION

State of Wisconsin }
County of Oneida } ss.

I JAMES D. REIN, do hereby certify that on the 28th day of August, 1979, I found evidence of the One-quarter corner of between sections 19 & 30 Township 37 north, Range 8 east, Fourth Principal Meridian, as described hereon; and that from this evidence I established a new monument and accessories as described hereon to perpetuate the original location of this corner:

Description of original monument and accessories and subsequent restorations:



wood post set by William E. Dougherty, Deputy Surveyor, July 24, 1863, witnessed by a 6" white pine N7°W, 8 lks (5.28 feet) and by an 8" aspen S31°W, 11 lks (7.26 feet).
D. N. Vaughn, Oneida County Surveyor, January 12, 1899 set post at proportionate distance between section corners.
Keith Hall, Surveyor, January 1944 set monument at proportionate distance between section corners. witnessed by peak of high boulder S64°E, 116.3 feet, "x" on low boulder N25°E, 28.0 feet and by a 3" aspen, S70°E, 8.4 feet.

Description of corner evidence found:

iron pipe 3/4" in diameter damaged by recent logging
"x" on low boulder N25°E, 28.03 feet
high boulder has been removed by road construction.

Description of monument and accessories I established to perpetuate the location of this corner:

I set an aluminum Oneida County survey marker, 2" in diameter and 30" long with 3-1/4" diameter cap, 22" in ground to replace the damaged 3/4" diameter pipe. made bearing trees with r.n. nails set in lower blaze as follows:
8" oak N80°W, 31.47 feet
10" white Birch S10°W, 4.80 feet

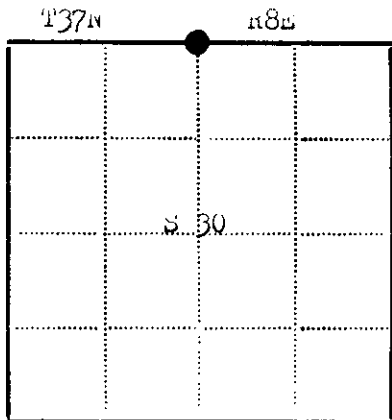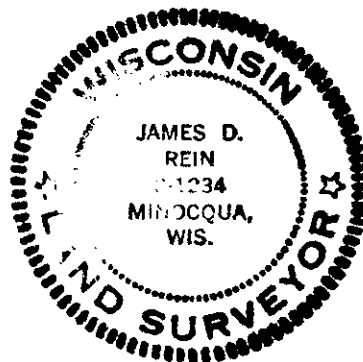

● - Corner monument restored
□ -

Resident witnesses None

Dated at Minocqua Wisconsin, this 10th day of September 1979.

Signature James D Rein Title Land Surveyor
(County Surveyor, Registered Land Surveyor, or other duly authorized official)

Surveyors Registration No. 5-1234

Office of REGISTER OF DEEDS County of Oneida

I hereby certify that the within instrument was filed in this office for record on the 17th day of September 1982, and was filed in Book No. _____ Page No. _____ of County Records.

Signature Loris Verge Kuehn Title REGISTER OF DEEDS

Township _____, Range _____, Section _____, Index No. _____, Page No. _____

R-3