

This form is intended to fulfill the requirements of Chapter A-E 7.08 (3)(a) thru (i) U.S. Public Land Survey Monument Location Record, Wisconsin Administrative Code. Use the reverse side of form for continuation.

U.S. PUBLIC LAND SURVEY MONUMENT LOCATION RECORD

USPLS CORNER: SOUTH WITNESS MC SECTION: 20 TOWNSHIP: 37 NORTH RANGE: 8 EAST

NAME OF WATERWAY FOR M.C. CORNER: MILDRED LAKE SECTION LINE: WEST

(CITY)(VILLAGE)(TOWN) OF: NEWBOLD COUNTY OF: ONEIDA

Description of monument found or placed and all other evidence used as the basis for monument location; including monuments and related measurements required if the corner location was reestablished by lost corner proportionate methods. Also indicate name of original surveyor, original survey date and the corner monument, bearing trees, witness or other reference monuments established; including measured bearing and distance ties, from available records.

Found and accepted an old 3/4" dia. heavy duty iron pipe with uncapped top 12" up and tipped slightly North at this corner location; I plumbed and secured the old iron pipe and drove a standard 2" dia. by 30" long aluminum pipe monument with stamped Oneida County cap over the old iron pipe to 6" above grade; the corner falls 8' South of existing lake shoreline bearing East/West.

In July 1863, William E. Daugherty/GLO set a wood post as the original corner and marked OBTs: a 6" Bw S43°W 28 links and a 7" Bw S56°E 17 links; all are now obliterated.


In June 1983, James F. Kasson/RLS 1416 found a 3/4" iron pipe at this corner as previously set by Hall, and noted a 14" Pr BT S71°W 34.10' per Plat of Survey filed as B-446 in Oneida County survey records; BT found OK and used for new ties.

In 1980 William E. Badow/RLS 1182 notes an iron pipe found at this corner per Oneida County Certified Survey Map No. 798 recorded June 26, 1980 in Oneida County records.

Corner is located in woods West of an improved lake frontage lot with buildings at Fire No. 7228A Mildred Lake Road off North end of dead end cul-du-sac roadway.

This recovery completed October 2, 2002 and indirectly witnessed by East adjoiner owner.

Plan view map of monument location with bearing and distance ties to a minimum of four(4) described witness or reference monuments of concrete, natural stone, iron, live bearing trees or equivalent material. If applicable, also show a minimum of two(2) bearing and distance ties to any other monument found and not accepted; including the bearing and distance from the accepted monument.

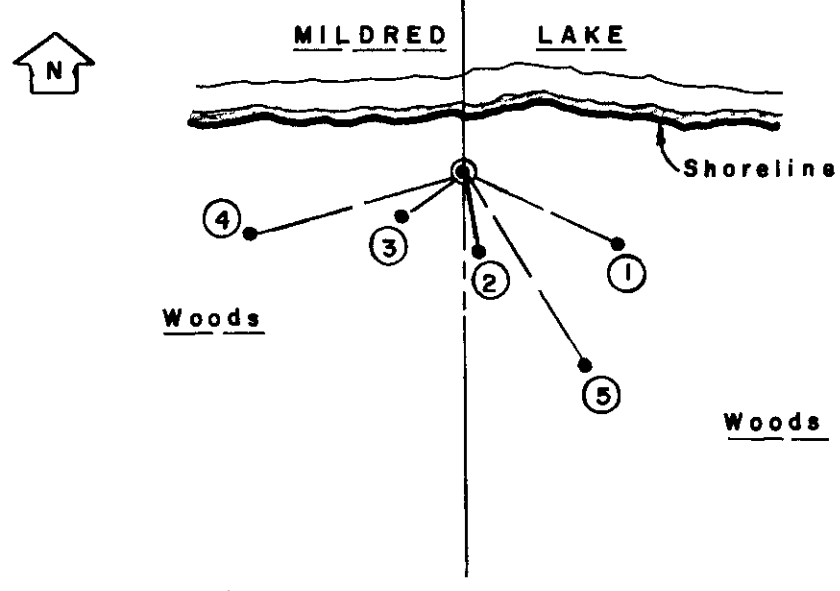


WITNESS MONUMENT TIES:

- ① New 10" Pw BT S65°E 26.06'.
- ② New center 7" Mr of 3 BT S11°E 12.88'.
- ③ New 5" Pw BT S55°W 11.55'.
- ④ Old 16" Pr BT with lower face blaze scar plain S73°W 34.39'.
- I set a standard white poly 'T' marker post 6" North of the corner monument.
- ⑤ New 6.5" Pw BT S32°E 35.11'.

SCALE: 1" = 30'

Unless otherwise indicated, all bearing tree ties are to a .25" dia. by 2.5" long PK nail with a 1.25" dia. steel washer driven into unblazed right face and a .25" dia. by 2.5" long PK nail with a 2" dia. steel washer stamped BT is also driven into unblazed face of bearing tree at DBH; the basis for measured bearings is by compass to nearest degree and all tie distances are measured horizontal by steel tape corrected to nearest 1/100th feet at standard temperature of 68° F.


RLS SEAL:

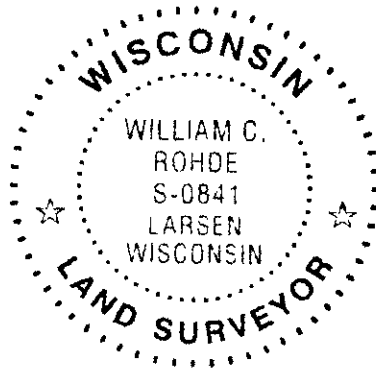

LAND SURVEYOR CERTIFICATE:

I, William C. Rohde, hereby certify that I am duly licensed as a Professional Land Surveyor in the State of Wisconsin; that this USPLS monument location was determined by me and/or under my direct supervision and control; and that this U.S. Public Land Survey Monument Location Record is true and correct to the best of my knowledge and belief.

Signed *William C. Rohde*
William C. Rohde RLS 841

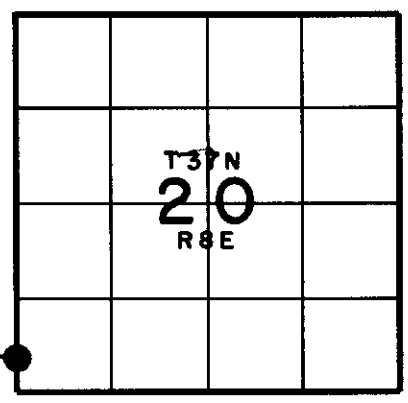

SECTION LOCATION MAP
INDEX NO. QR5

Date Signed: March 1, 2003

3708 190300