

CERTIFIED LAND CORNER RESTORATION

State of Wisconsin }
County of Oneida } ss.

I, James D. Rein, do hereby certify that on the 27th day of March, 1979, I found evidence of the east one-quarter corner of Section 19 Township 37 North, Range 8 East, Fourth Principal Meridian, as described hereon; and that from this evidence I established ~~new monuments and~~ accessories as described hereon to perpetuate the original location of this corner:

Description of original monument and accessories and subsequent restorations:



wood post set by William E. Dougherty, Deputy Surveyor on July 29th, 1863, witnessed by an 8" birch N88°W, 28 links (18.48 feet) and by an 18" Yellow Pine N86°E, 13 links (8.58 feet)
wood post found by F. K. Wincentzen witnessed by the following old bearing trees: 22" Norway Pine S89°E, 24 links (15.84 feet) and by a 28" white Pine S65°W, 80 links (52.80 feet)

Description of corner evidence found:

2" diameter iron pipe flush and surrounded by pile of rocks, remains of 3" x 3" scribed post down, new maple post by others. witnessed by a 20" Norway Pine S89°E, 15.43 feet (scar visible) and by a 26" white Pine S65°W, 52.82 feet (scribed with 9 inches of overgrowth).

Description of ~~monument and~~ accessories I established to perpetuate the location of this corner:

Made ties to witness the existing iron pipe as follows:
Set P.K. nail in existing bearing tree 20" Norway Pine S89°E, 15.43 feet;
Set P.K. nail in existing bearing tree 26" white Pine S65°W, 52.82 feet;
made bearing tree with P.K. nail set in lower face 18" Norway Pine bearing S7°E, 52.64 feet.

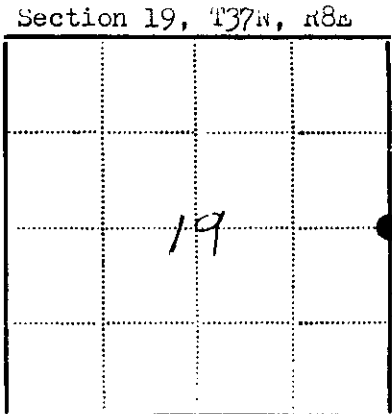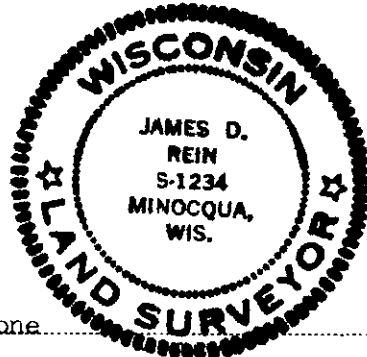

Legend: dot = Corner monument restored, square =

Resident witnesses none

Dated at Minocqua Wisconsin, this 10th day of September, 1979.

Signature James D. Rein Title Land Surveyor (County Surveyor, Registered Land Surveyor, or other duly authorized official)

Surveyors Registration No. S-1234

Office of REGISTER OF DEEDS County of Oneida

I hereby certify that the within instrument was filed in this office for record on the 17th day of September, 1982, and was filed in Book No. Page No. of County Records.

Signature Doris Verge Kuehn Title REGISTER OF DEEDS

Township, Range, Section, Index No., Page No.

3708192000

P-5