

CERTIFIED LAND CORNER RESTORATION

State of Wisconsin }
County of Oneida } ss.

I, James D. Rein, do hereby certify that on the 27th day of March, 1979, I found evidence of the original Section corner of Sections 20, 21, 29 and 28 Township 37 North, Range 8 East, Fourth Principal Meridian, as described hereon; and that from this evidence I established ~~new monuments and~~ accessories as described hereon to perpetuate the original location of this corner:

Description of original monument and accessories and subsequent restorations:

wood post set by William B. Dougherty, Deputy Surveyor, July 22nd, 1863, witnessed by an 8" Tamarack S26°W, 27 lks (17.82 feet) and by a 7" Spruce N34°W, 16 lks (10.56 feet). Keith Hall, Surveyor in January, 1944 found point of original stake and original 8" Tamarack S26°W, 17.8 feet. He set 3" iron pipe and made new ties: mark on boulder S72°W, 33.5 feet
9" Dead Tamarack S60°W, 8.5 feet.


Description of corner evidence found:

3" diameter iron pipe with coupling up 6" in swamp west of pond.
remains of original stump S28°W, 17 feet badly decayed.
9" Tamarack stub S60°W, 8.32 feet (note this tree has a notch facing Southeast, "X" on boulder S72°W, 32.37 feet.

Description of ~~monument and~~ accessories I established to perpetuate the location of this corner:

made bearing trees with P.A.S set in lower blaze as follows:

6" Tamarack N38°W, 19.25 feet
6" black spruce S1°W, 20.99 feet

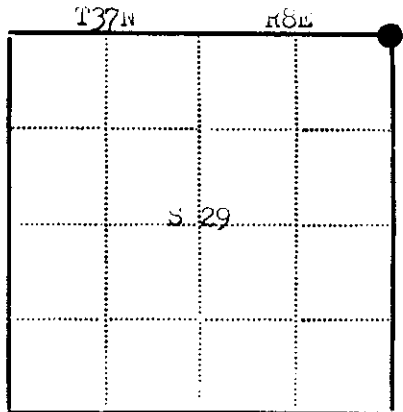

● - Corner monument restored
□ -

Resident witnesses none

Dated at Minocqua Wisconsin, this 10 day of September 1979

Signature James D. Rein Title Registered Land Surveyor
(County Surveyor, Registered Land Surveyor, or other duly authorized official)

Surveyors Registration No. 5-1234

Office of REGISTER OF DEEDS County of Oneida

I hereby certify that the within instrument was filed in this office for record on the 17th day of September 1982, and was filed in Book No. Page No. of County Records.

Signature Louis George Kuehn Title REGISTER OF DEEDS

Township, Range, Section, Index No., Page No.

3708200000

200