U.S. PUBLIC LAND SURVEY MONUMENT RECORD

Note: This form is intended and designed to fulfill all requirements of Wisconsin Administrative Code, Chapter A-E 7.08 U.S. Public Land Survey Monument Record (3) (a) (b) (c) (d) (e) (f) (g) (h) (i). An additional sheet may be added if necessary to conform with said requirements.

(a) Corner location: Township 37 North

Range 8 East/~~West~~

Town/~~City/Village~~ Newbold

County Oneida

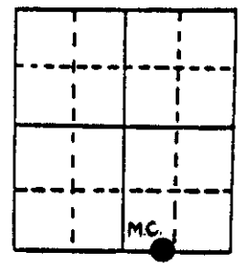

Section 20

(b) (f) (g) (h) Description of monument found at this corner and if it was accepted, state all evidence (material, testimonial, occupational, plats, records, other monuments) used as a basis for accepting. If not accepted or if nothing was found, state evidence used as basis for establishing location. If reestablished through lost corner proportionate methods, indicate all monuments, distances and directions used to establish. Indicate type of monument found or set and sign post.

-1863- Daugherty set M.C. Birch 6" N 8 E 5 lks., Birch 10" S 80 E 21 lks.
-1956- Poskie at corner W. Pine 16" S 23 E 12.5', W. Pine 17" S 60 E 11.4'
-1963- Poskie at corner
-1983- Kasson found 1" iron pipe B.T.'s W. Pine 18" S 19 E 12.76', W. Pine 16" S 59 E 11.84'
-1989- William E. Bandow found iron pipe in place, replaced with Oneida County Monument and witnessed as shown below. W. Plastic Post West 1'

(c) (d) (e) Plan view of corner with ties to at least 4 witness monuments. If in disagreement with previously established corner, show the distances between the two corners and also indicate the ties to the disputed corner.

NOTE:

DISTANCE MEASURED TO A 6" SPIKE IN SIDE OF TREE

BEARINGS TAKEN WITH A HANDHELD MAGNETIC COMPASS

NO SCALE

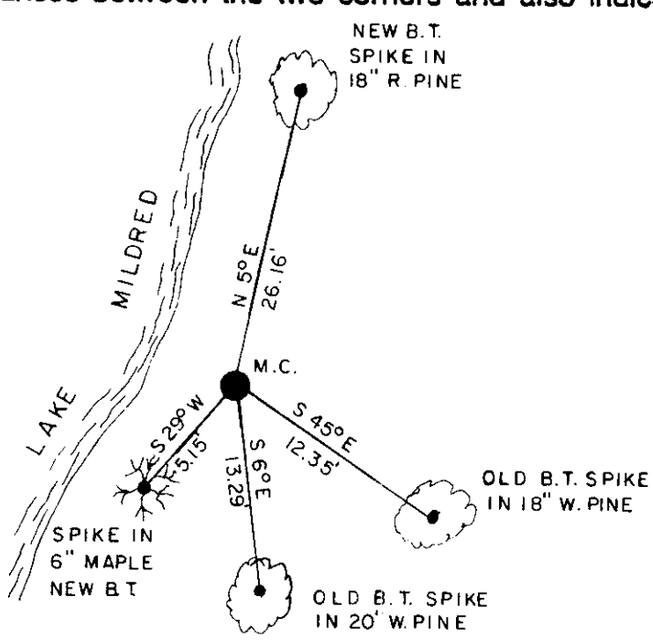

REGISTER OF DEEDS OFFICE
ONEIDA COUNTY, WIS
FILED
FEB 7 1991
At _____ O'Clock _____ M
THOMAS H. LEIGHTON
REGISTER OF DEEDS

(i) I, William E. Bandow (type or print name) certify that the corner location on this record was determined by me or under my direction and control and that this U.S. Public Land Survey Monument Record is correct and complete to the best of my knowledge and belief.

William E. Bandow 2-1-91

Signature Date

WISCONSIN
WILLIAM E. BANDOW
S-1182
RHINELANDER WIS.
LAND SURVEYOR

Index No. R-78

37082008