U.S. PUBLIC LAND SURVEY MONUMENT RECORD

Note: This form is intended and designed to fulfill all requirements of Wisconsin Administrative Code, Chapter A-E 5.02, U.S. Public Land Survey Monument Record (3) (a) (b) (c) (d) (e) (f) (g) (h) (i). An additional sheet may be added if necessary to conform with said requirements.

(a) Corner location: Township 37 North

Range 8 East/~~West~~

Town/~~City/Village~~ Newbold

County Oneida

REGISTER OF DEEDS OFFICE ONEIDA COUNTY, WIS.

At 8:00 O'Clock A M

DEBRA VERNON KUEHN REGISTER OF DEEDS

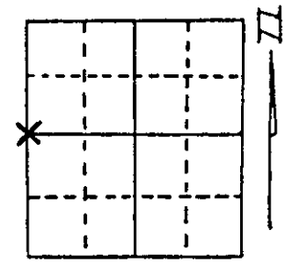

Section 22

(b) (f) (g) (h) Description of monument found at this corner and if it was accepted, state all evidence (material, testimonial, occupational, plats, records, other monuments) used as a basis for accepting. If not accepted or if nothing was found, state evidence used as basis for establishing location. If reestablished through lost corner proportionate methods, indicate all monuments, distances and directions used to establish.

July 1863, Wm. E. Daugherty at 40.00 chains set 1/4 section post:
6" Jack Pine, S68°E, 6 links (3.96')
15" Red Pine, S67°W, 38 links (25.08') - stump hole remains
December 2, 1987 Milo E. Stefan found 1" iron pipe, 6" high with:
14" Jack Pine, S60°W, 3.4', scribed "1/4S BT Ø" (20 years old);
8" Jack Pine stub, 6' high, N15°E, 1.6', scribed"1/4S BT"(50 years old).
I accept the position of the iron pipe as the corner.

(c) (d) (e) Plan view of corner with ties to at least 4 witness monuments. If in disagreement with previously established corner, show the distances between the two corners and also indicate the ties to the disputed corner.

1. 2" x 30" Oneida County aluminum monument with 1" iron pipe dirven alongside.
2. 6" Jack Pine, N52°E, 21.66' *
3. 6" Jack Pine, S45°E, 3.99' *
4. 14" Jack Pine, S60°W, 3.43'
5. 14" Red Pine, S80°W, 78.31' *
6. Plastic sign post, South, 1.0'

Distances measured to nail in side of trees.
* BTs scribed "1/4S BT"

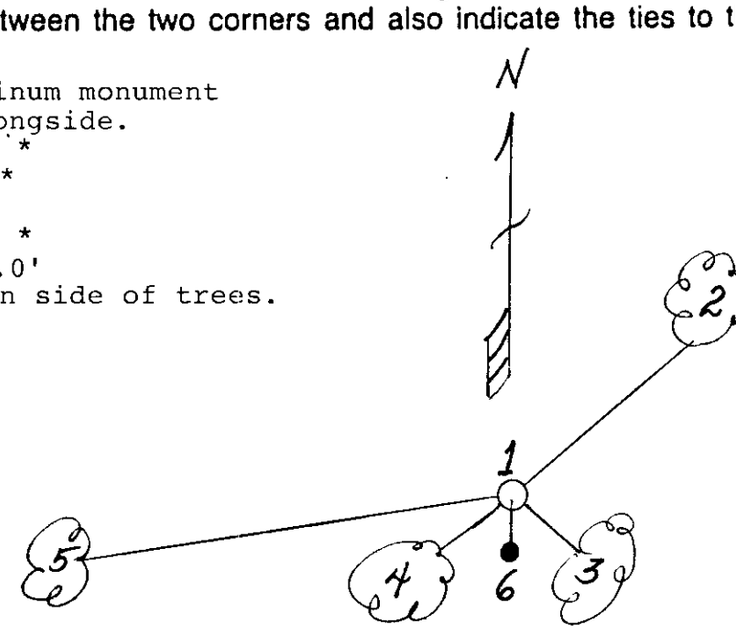

(i) I, Milo E. Stefan (type or print name) certify that the corner location on this record was determined by me or under my direction and control and that this U.S. Public Land Survey Monument Record is correct and complete to the best of my knowledge and belief.

Milo E Stefan 1/4/88

Signature Date

WISCONSIN MILO E. STEFAN S-1558 RHINELANDER, WIS. LAND SURVEYOR

Index No. P-13

370821 2000