




# U.S. PUBLIC LAND SURVEY MONUMENT RECORD

**Note:** This form is intended and designed to fulfill all requirements of Wisconsin Administrative Code, Chapter A-E 7.08 U.S. Public Land Survey Monument Record (3) (a) (b) (c) (d) (e) (f) (g) (h) (i). An additional sheet may be added if necessary to conform with said requirements.

(a) Corner location: Township 37 North  
 Range 8 East/West

Town/City/Village Newbold

County Oneida

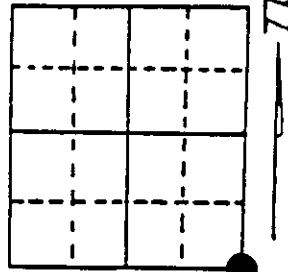

Section 22

(b) (f) (g) (h) Description of monument found at this corner and if it was accepted, state all evidence (material, testimonial, occupational, plats, records, other monuments) used as a basis for accepting. If not accepted or if nothing was found, state evidence used as basis for establishing location. If reestablished through lost corner proportionate methods, indicate all monuments, distances and directions used to establish. Indicate type of monument found or set and sign post.

1863 - Wm. E. Daugherty established this corner and set a wood post with two BTs:  
 8" Black Pine, N48°E, 31 Links      10" Black Pine, S46°W, 46 Links


1902 thru 1986: See reverse side.

4/1992 - Milo E. Stefan in working S½ SE¼ located 1" iron pipe bent over. Questioned southwest BT by Schmits to possibly have been one of Vaughan's BTs. I destroyed it for annual ring count and found it to be twenty years too young. I, therefore, replaced the iron pipe with an aluminum monument, verified the three old BTs, made one new BT and set plastic sign post.

(c) (d) (e) Plan view of corner with ties to at least 4 witness monuments. If in disagreement with previously established corner, show the distances between the two corners and also indicate the ties to the disputed corner.

- 1) 2" x 30" aluminum monument.
- 2) 12" Red Pine, S83°E, 77.18'.
- 3) 14" Red Pine, S31°E, 121.99'.
- 4) 6" Red Pine, S20°W, 138.92'.
- 5) 16" Red Pine, N25°W, 84.54'.
- 6) 15" Jack Pine Stump, S28°W, 62.76'.
- 7) Plastic sign post, N25°W, 82.00'.

Distances to nail in side of BTs.  
 Stump blaze scribed "BT".

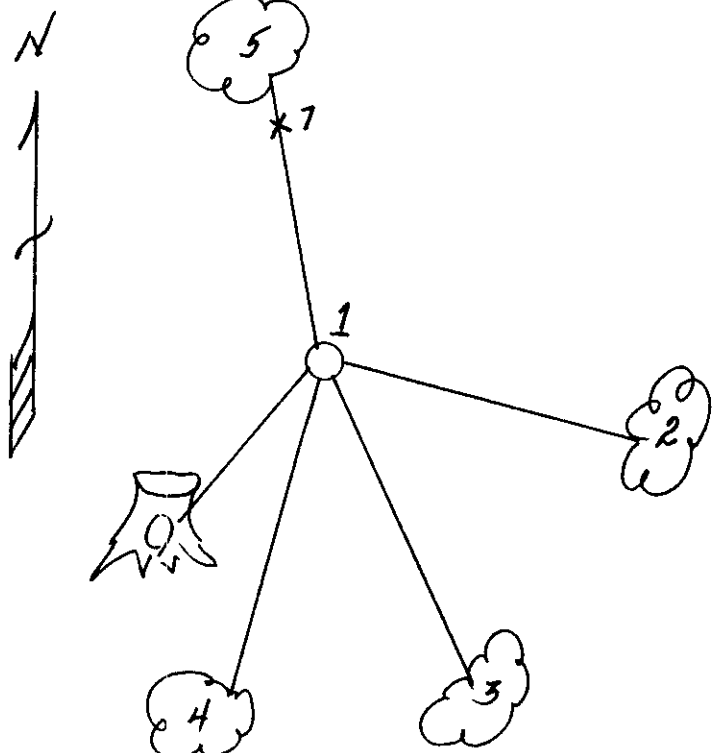

(i) I, Milo E. Stefan  
 (type or print name) certify that the corner location on this record was determined by me or under my direction and control and that this U.S. Public Land Survey Monument Record is correct and complete to the best of my knowledge and belief.

Milo E. Stefan  
 Signature

August 4, 1992  
 Date



Stamp

3705 220000

Index No. R-17

- 1902 - D.H. Vaughan ran from SE corner Section 22 West 42.21 chains to South Quarter Section 22. New BT for Southeast corner: 7" B. Pine, S15½°W, 78½ links and 18" Yellow Pine, S67½°E, 108 links (no marks). Ran from S Quarter of 23, West 42.14 chains to Southwest corner of 23. Ran from West Quarter of 26 North 41.48 chains to Northwest corner of 26.
- 1908 - D.H. Vaughan states Northwest corner of 26 okay. Black Pine broken down. Ran South 41.90 chains to the West Quarter of 26. He also states he ran from corner to 22-23-26-27 South on Section Line for road.
- 1953 - F.R. Wincentzen indicates corner 22, 23, 26, 27 distance East to Quarter = 2781.24 feet.
- 1975 - L. Schmit indicates iron rod at corner. BT 12" Jack Pine, S23°W, 61.40 feet.
- 1976 - Sy Poskie recovered corner.
- 1986 - Michael J. Romportl found a 1" iron pipe agreeing with Schmits BT and witnessed it.

