


Public Land	intended and designed to fulfill all requirements of Wisconsin Survey Monument Record (3) (a) (b) (c) (d) (e) (f) (g) (h) (i). Ar	n Administrative Code, Chapter A-E 5.02, U.S n additional sheet may be added if necessary
contorm wit	h said requirements. ion: Township <u>37</u> North	
	Range8East /West	1 1
Town/ Gity/∀illag	e Newbold	1 1
County	Oneida	1 1
		26
(material, tes	escription of monument found at this corner and timonial, occupational, plats, records, other monument	nents) used as a basis for accepting. I
(material, tes not accepted reestablished	escription of monument found at this corner and timonial, occupational, plats, records, other monund or if nothing was found, state evidence used through lost corner proportionate methods, inceed to establish.	if it was accepted, state all evidence nents) used as a basis for accepting. I as basis for establishing location.

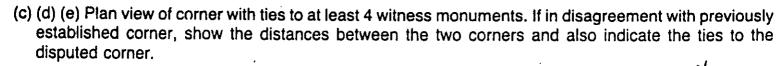

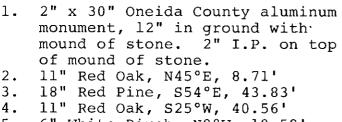

- 3.
- 6" White Birch, N9°W, 19.58' 5.
- White plastic sign post. BT's scribed "T37N, R8E, S (Section) BT". Measurements from nail on side of BTs.

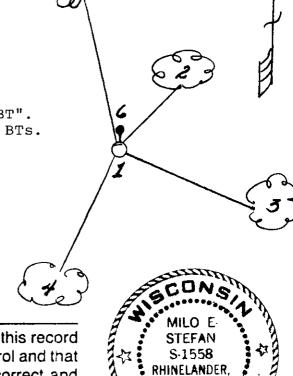

Milo E. Stefan

(type or print name) certify that the corner location on this record was determined by me or under my direction and control and that this U.S. Public Land Survey Monument Record is correct and complete to the best of my knowledge and belief.

Date