U.S. PUBLIC LAND SURVEY MONUMENT RECORD

Note: This form is intended and designed to fulfill all requirements of Wisconsin Administrative Code, Chapter A-E 7.08 U.S Public Land Survey Monument Record (3) (a) (b) (c) (d) (e) (f) (g) (h) (i). An additional sheet may be added if necessary to conform with said requirements.

(a) Corner location: Township 37 North

Range 8 East/~~West~~

Town/~~City/Village~~ Newbold

County Oneida

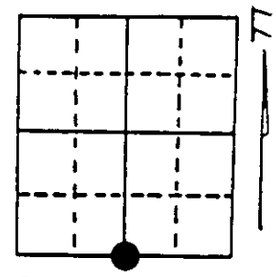

Section 23

(b) (f) (g) (h) Description of monument found at this corner and if it was accepted, state all evidence (material, testimonial, occupational, plats, records, other monuments) used as a basis for accepting. If not accepted or if nothing was found, state evidence used as basis for establishing location. If reestablished through lost corner proportionate methods, indicate all monuments, distances and directions used to establish. Indicate type of monument found or set and sign post.

July 1863 - Wm. E. Daugherty established this corner at 39.91 chains and set a wood post with two BTs:
18" Red Pine, S23°E, 33 links (21.87')
12" Red Pine, N12°W, 56 links (36.96')

1916 - Vaughan made note that SE BT had iron marks plain.

8/3/1953 - Wincentsen set iron in road with two Witness Corners from original BT remains, north and south of corner 26.4'.

10/1987 - Winat used this corner and was to restore it.

5/2/1992 - Milo E. Stefan found corner not up to standard and took this opportunity to restore the corner. I set an aluminum monument, made new BTs and set sign post.

(c) (d) (e) Plan view of corner with ties to at least 4 witness monuments. If in disagreement with previously established corner, show the distances between the two corners and also indicate the ties to the disputed corner.

1) 2" x 30" aluminum monument.
2) 8" Red Pine, N38°E, 57.79'.
3) 10" Red Pine, S77°W, 83.88'.
4) 2" iron pipe, North, 26.40'.
5) 2" iron pipe, South, 26.40'.
6) Plastic sign post, North, 27.0'.

Distances to nail in side of BTs.
Stump blaze scribed "BT".

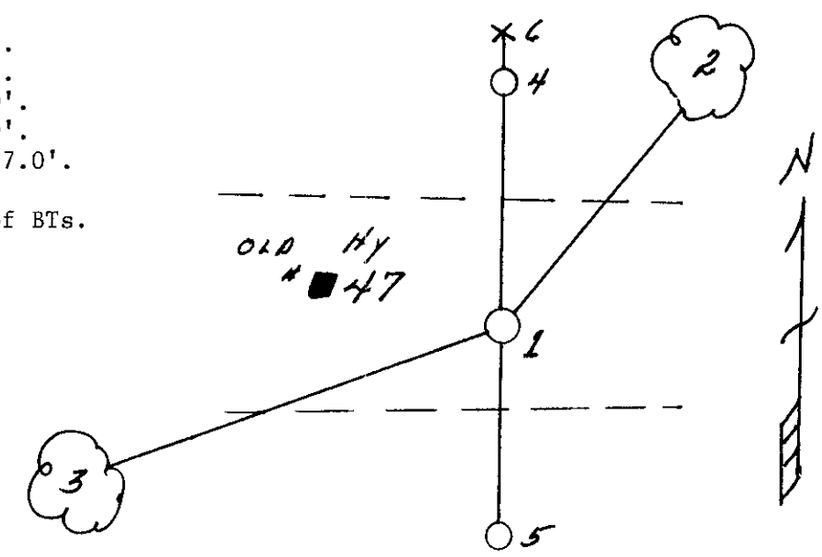

(i) I, Milo E. Stefan (type or print name) certify that the corner location on this record was determined by me or under my direction and control and that this U.S. Public Land Survey Monument Record is correct and complete to the best of my knowledge and belief.

Milo E. Stefan — August 4, 1992

Signature — Date

WISCONSIN MILO E. STEFAN S-1558 RHINELANDER, WIS. LAND SURVEYOR

Index No. R-19

Stamp 3708230020