


U.S. PUBLIC LAND SURVEY MONUMENT RECORD

Note: This form is intended and designed to fulfill all requirements of Wisconsin Administrative Code, Chapter A-E 7.08 U.S. Public Land Survey Monument Record (3) (a) (b) (c) (d) (e) (f) (g) (h) (i). An additional sheet may be added if necessary to conform with said requirements.

(a) Corner location: Township 37 North
 Range #9 East/West

Town/City/Village PINE LAKE

County ONEIDA

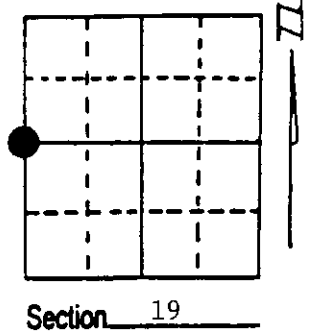

(b) (f) (g) (h) Description of monument found at this corner and if it was accepted, state all evidence (material, testimonial, occupational, plats, records, other monuments) used as a basis for accepting. If not accepted or if nothing was found, state evidence used as basis for establishing location. If reestablished through lost corner proportionate methods, indicate all monuments, distances and directions used to establish. Indicate type of monument found or set and sign post.

1860 - H.C. Fellows set wood post at 40.00 chains and made two BTs:
 12" White Pine, S40°E, 10 Links 12" Aspen, N61°W, 9 Links

6/28/1915 - Vaughan restored corner at road intersection. Called distance North to 'Section Corner' at 40.73 chains. Set 1 1/2" well point for corner.
 6/24/1993 - Milo E. Stefan found well point and another 1 1/4" iron pipe East 2.66'.
 We tied both off so as not to loose them when road was to be resurfaced this summer.


4/19/1994 - We returned and set railroad spike for corner position, set reference monuments, BTs and plastic sign post. Measured distance North to restored Section Corner - is 2670.38 feet.

(c) (d) (e) Plan view of corner with ties to at least 4 witness monuments. If in disagreement with previously established corner, show the distances between the two corners and also indicate the ties to the disputed corner.

- 1) Railroad spike.
- 2) 2" x 36" aluminum monument, N85°E, 29.92'.
- 3) Reference, N85°E, 57.85'.
- 4) 6" Red Pine, S42°W, 140.87'.
- 5) 12" Scotch Pine, N66°E, 25.14'.
- 6) 18" Red Pine, S64°E, 63.38'.
- 7) Plastic sign post

Distances to nail in side of BTs.
 Stump blazes scribed "BT".

Handwritten notes:
 well point.
 note on
 nearby files.
 L1851

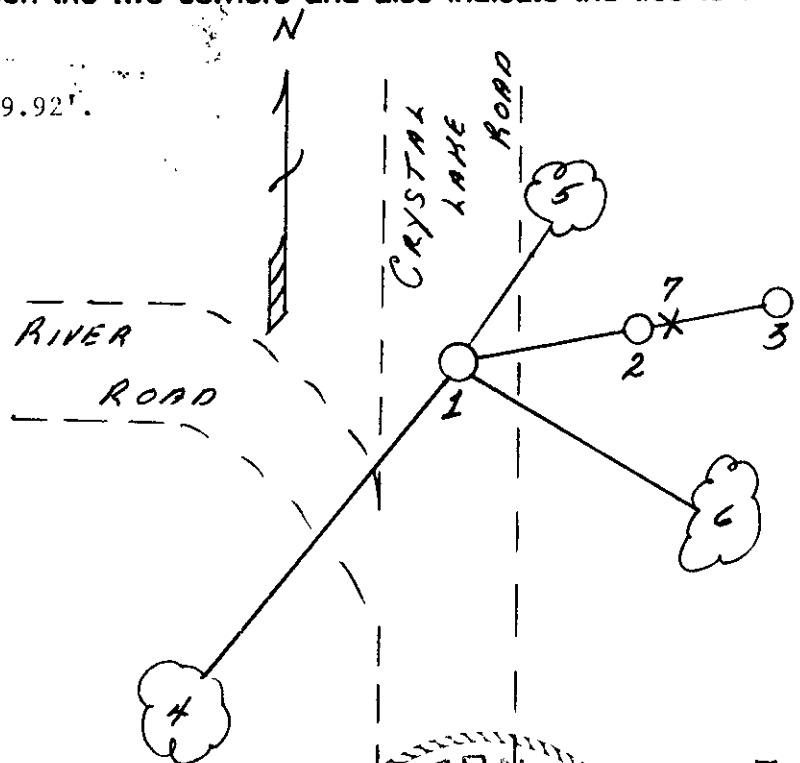

(i) I, Milo E. Stefan
 (type or print name) certify that the corner location on this record was determined by me or under my direction and control and that this U.S. Public Land Survey Monument Record is correct and complete to the best of my knowledge and belief.

Milo E. Stefan
 Signature

5/9/94
 Date



Index No. P-1

Stamp 3708242000