

State of Wisconsin

County of ONEIDA } ss.

I JAMES D. REIN do hereby

certify that on the tenth day

of April 19 81, I found

evidence of the South one-quarter

corner of Section 26

Township 37 North, Range

8 East, Fourth Principal Meridian,

as described hereon; and that from this evidence

I established a new monument and accessories

as described hereon to perpetuate the original

location of this corner.

Resident witnesses:

Steven E. Toede

Stephen E. Toede

Stephen E. Toede

ONEIDA COUNTY, WIS.

History of original corner establishment:

July 17th, 1863 - WILLIAM E. DAUGHERTY, Deputy Surveyor set Wood Post, witnessed by Birch 8" N50°E, 26 lks (17.16 feet) and by a White Pine S40°W, 82 links (54.12 feet).

January 10th, 1893 - B. F. DORR, Oneida County Surveyor in Section 35 found N 1/4 P (Book No. 3 page 74).

August 19th, 1908 - D. H. VAUGHAN, Oneida County Surveyor in Section 35 found N 1/4 P (Book No. 6, page 42).

Description of corner evidence found:

Old corner post to good fence lines (mostly down) which run South and East, poor fence line mostly down North. Orig. White Pine Stump bears S20°W, 54 feet. Remains of rotten White Birch roots bear N50°E 17 feet. A 1" diameter iron pipe shown in several recent surveys as monumenting the quarter corner location bears N76°E, 15.77 feet.


Note: Milo Stefan, Registered Land Surveyor and Forester with the U. S. Forest Service, identified the tree species of the White Pine Stump and remains of the White Birch roots.

Description of monument and accessories I established to perpetuate the original location of this corner.

Set in Oneida County Aluminum Berntsen Standard Monument 30" long, 24" in the ground to replace the Corner Post. Made bearing trees scribed "1/4 S B.T." with a P.K. nail set in lower face as follows:

- 8" Oak N29°E, 27.23 feet
- 15" Norway Pine N33°W, 86.68 feet
- 6" Red Maple, S79°W, 19.00 feet

This is a copy of the original of the original. The original was apparently misplaced or is lost. James D. Rein, County Surveyor.

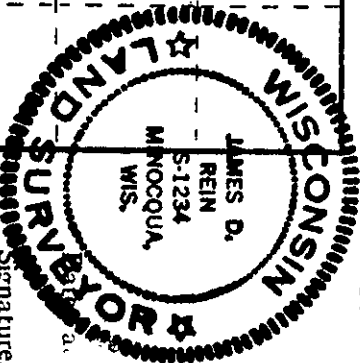

Signature James D. Rein Title Registered Land Surveyor Registration No. S-1234
(County Surveyor, Registered Land Surveyor, or other duly authorized official)

Office of Register of Deeds, County of Oneida, Wisconsin, this 30th day of April, 19 81.
I hereby certify that the within instrument was filed in this office for record on the 30th day of April, 19 81 at 10 o'clock A. M.

(Register of Deeds)

○ = Corner monument restored.

By James D. Rein Deputy

3708260020