

U.S. PUBLIC LAND SURVEY MONUMENT RECORD


Note: This form is intended and designed to fulfill all requirements of Wisconsin Administrative Code, Chapter A-E 5.02, U.S. Public Land Survey Monument Record (3) (a) (b) (c) (d) (e) (f) (g) (h) (i). An additional sheet may be added if necessary to conform with said requirements.

(a) Corner location: Township 37 North

Range 8 East ~~West~~

Town ~~City/Village~~ Newbold

County Oneida

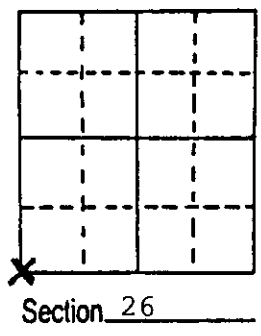

(b) (f) (g) (h) Description of monument found at this corner and if it was accepted, state all evidence (material, testimonial, occupational, plats, records, other monuments) used as a basis for accepting. If not accepted or if nothing was found, state evidence used as basis for establishing location. If reestablished through lost corner proportionate methods, indicate all monuments, distances and directions used to establish.

July 1863, Wm. E. Daugherty, set post for section corner
 Original BTs - 15" Red Pine, N8°E, 427 links (281.82').
 - 15" Red Pine, S10°W, 375 links (247.50').


- November 20, 1987 Milo E. Stefan found:
1. 2" x 48" iron pipe with 2 large post points deep in swamp.
 2. Scribed Red Pine stump, N18°E, 276.3' (scribed "S26 BT" "VIXI").
 3. Remains of very decayed Red Pine stump & stump hole N8°E, 282'.
 4. Swamp calls North, South & West fit well, not checked East.
 5. Southwest BT was destroyed in pipeline construction.

I accept the post points as the true original position of this section corner.

(c) (d) (e) Plan view of corner with ties to at least 4 witness monuments. If in disagreement with previously established corner, show the distances between the two corners and also indicate the ties to the disputed corner.

1. 2" x 30" Oneida County aluminum monument atop post point driven 18" into muskeg swamp.
2. 5" Tamarack, N12°E, 58.92'.*
3. 5" Tamarack, S88°E, 17.28"*. *
4. 3" Tamarack, S7°W, 5.45'. (scribed "X BT")
5. 4" Tamarack, N43°W, 22.91"*. *
6. Red Pine stump, N18°E, 176.3' scribed many years ago.
7. White plastic sign post, NE, .50'

*Scribed "T37N R8ES(Section) BT"

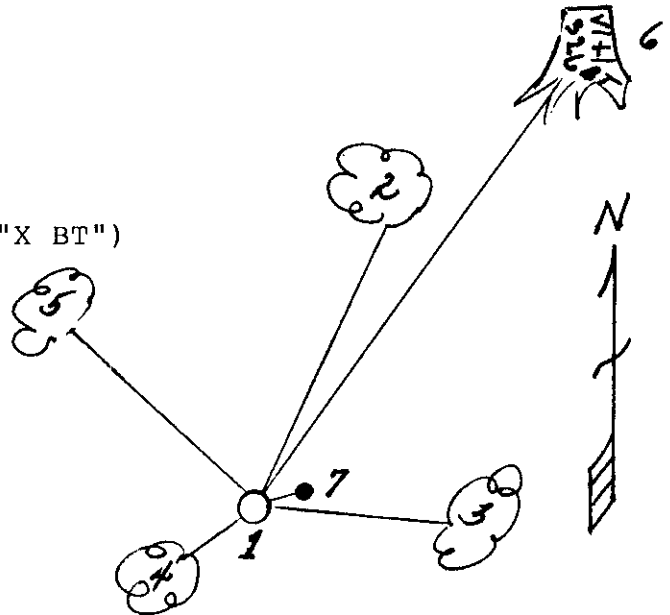

(i) I, Milo E. Stefan
 (type or print name) certify that the corner location on this record was determined by me or under my direction and control and that this U.S. Public Land Survey Monument Record is correct and complete to the best of my knowledge and belief.

Milo E. Stefan
 Signature

11/30/87
 Date



Index No. V-17

3708270000